

LAND CORNER RECORDATION CERTIFICATE

Filing Requirement of Act 74, Mich. PA 1970

| | | |
|--|--|---------------|
| For Corners In: <u>Benzie</u> (County) | Located In | Corner Code # |
| 1. Public Land Survey | T _____ R _____ T _____ R _____ | _____ |
| 2. Property Controlling in Section | S 32 T 26N R 13W S _____ T _____ R _____ | 8, 9 |
| 3. Miscellaneous Property in Section | S _____ T _____ R _____ S _____ T _____ R _____ | _____ |
| 4. Lot No: _____ | Recorded Plat: _____ | |
| 5. Private Claims: _____ | | |

2016-00026


STATE OF MICHIGAN
BENZIE COUNTY
RECORDED
01/27/2016 12:46:20PM
REC FEE: \$14.00
PAGE 1 OF 1
57231

AMY J BISSELL
REGISTER OF DEEDS

Register of Deeds Stamp & File Number

I, Joshua R. Davidson, in a field survey on August 6, 2014 do hereby state that under requirements of PA 74, Michigan PA of 1970, the corner points mentioned in lines 1 and 2 above were in conformance with regulations and rules therefore as required in the current manual of survey instructions of the United States Department of the Interior, Bureau of Land Management or by a decree of a Court of Law and/or that the corner points mentioned in lines 3, 4 and 5 above were in conformance with the rules of the Michigan Board of Land Surveyors or by a Decree of a Court of Law; established, re-established, monumented, recovered, found as expressed below:

NOTE: Not more than 2 corners, all in the same town and range, may be recorded on this certificate.

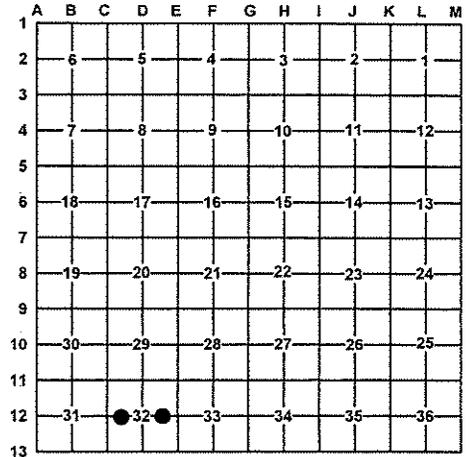

A. Description of original monument and accessories and/or subsequent restoration:

8 – CW 1/16 corner section 32

9 – CE 1/16 corner section 32

– None.

– None.

RECEIVED
BENZIE COUNTY
REGISTER OF DEEDS
2016 JAN 27 PM 12 41



B. Description of corner evidence found and/or method applied in restoring or re-establishing corner:

8 – CW 1/16 corner section 32

9 – CE 1/16 corner section 32

Set a stamped 2" aluminum cap on 5/8" X 34" rebar per standard BLM procedure.

Set a stamped 2" aluminum cap on 5/8" X 34" rebar per standard BLM procedure.

C. Description of monument for corner and accessories established to perpetuate locating the position of the corner:

8 – A stamped 2" aluminum cap on 5/8" x 34" rebar.

9 – A stamped 2" aluminum cap on 5/8" X 34" rebar.

N44°E 10.19' to set nail & tag in SE. side 10" Sugar Maple
S48°E 6.81' to set nail & tag in NE. side 4" Sugar Maple
S83°W 52.35' to set nail & tag in S. side 18" Sugar Maple
N49°W 18.59' to set nail & tag in NE. side 14" Sugar Maple
Set blue post with location tag 1' Northwest

N43°E 18.44' to set nail & tag in SE. side 8" Sugar Maple
S20°E 35.72' to set nail & tag in E. side 9" Sugar Maple
S51°W 23.45' to set nail & tag in SE. side Ironwood
N45°W 21.20' to set nail & tag in SW. side 4" Sugar Maple
Set blue post with location tag 1' Northeast

Signed by: Joshua R. Davidson
Surveyor's Michigan License No.: 46659

Date: 1-27-2016