

Land Corner Recordation Certificate
Authority: 1970 PA 74, MCL 54.205


Surveyor's Name: Craig W. McVean Field Survey Date: April 28, 2016
For corner(s) in: Benzie County

Original Public Land Survey Corner Corner Code
S T R
S T R
S T R
S T R

Property Controlling Corner Corner Code
S 15 T 26N R 14W 6
S 15 T 26N R 14W 9
S T R
S T R

Property Corner Corner Code
S T R
S T R
S T R
S T R

Protracted Public Land Survey Corner Corner Code
S T R
S T R
S T R
S T R

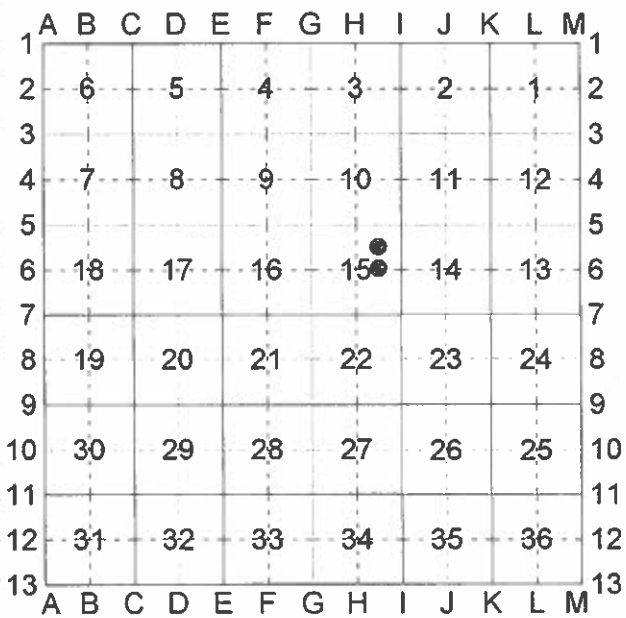

Part A: Corner History

- 6 - Date Unknown - Unrecorded Survey - R. M. Harris (PS #25845) - Iron stake set
- 9 - Date Unknown - Unrecorded Survey - R. M. Harris (PS #25845) - Iron stake set

**Part B: Surveyor's Report on Perpetuation, Restoration, Reestablishment, or Monumentation of Corner**

6 – NE 1/16 Corner Sec. 15 – T26N, R14W – Fd.  
½" capped iron rod #25845 – ½" CIR accepted as  
the best available evidence of the position of the  
corner

9 – CE 1/16 Corner Sec. 15, T26N, R14W – Fd.  
½" capped iron rod #25845 – ½" CIR accepted as  
the best available evidence of the position of the  
corner.

**Part C: Field Evidence of Perpetuation or Monumentation of Corner**

6 – NE 1/16 Corner Sec. 15, T26N, R14W – Replaced  
½" x 18" rebar with cap #25845 with stamped  
2" Aluminum Cap on 5/8" x 34" long iron rebar  
Set Blue Composite Post with Loc. Tag 1' SW  
S72°W 8.49' to set N & T in N. side 8" Red Pine  
N66°W 24.20' to set N & T in S. side 6" S. Maple  
N63°E 23.25' to set N & T in N. side 21" Cherry  
S09°W 14.20' to center of 4" stove pipe concrete  
monument

9 – CE 1/16 Corner Sec. 15, T26N, R14W  
Replaced ½" x 18" re bar with cap #25845 with  
Stamped 2" Aluminum Cap on 5/8" x 34" long iron  
rebar  
Set Blue Composite Post with Loc. tag 1' NW  
S77°W 9.66' to set N & T in S. side 8" Red Pine  
N48°W 10.71' to set N & T in NE side 11" Red Pine  
N38°E 11.54' to set N & T in SE side 12" Red Pine  
S57°E 28.68' to set N & T in S. side 4" Ironwood



*Craig W. McVean*

Craig W. McVean

4/3/2017  
Date

Professional Surveyor's License No.: 39088

Prepared By:  
Craig W. McVean  
Michigan Dept. of Natural Resources  
8015 Mackinaw Trail  
Cadillac, Michigan 49601