

RATIFIED BY THE BERRIEN COUNTY
SURVEY PEER GROUP AS THE
OFFICIAL CORNER UNDER MICHIGAN
PUBLIC ACT 345 OF 1990

Berrien County Remonumentation
LAND CORNER RECORDATION CERTIFICATE
Filing Requirement of Act 74, Mich. P.A. 1970

RECORDED

SEP 29 11 06 AM '95

Berrien County
REGISTER OF DEEDS
BERRIEN COUNTY MICHIGAN

For corners in

Berrien
(County)

Located In:

Corner Code #

1. Public Land Survey T 7S R 18W
Common to: T7S R19W, M-5
2. Property Controlling S T R
in Section S T R
3. Miscellaneous S T R
Property in Sec. S T R

A-5

M-05

Register of Deeds Stamp & File Number

4. Lot No. _____, Recorded Plat _____
5. Private Claims _____

I, Charles W. Barger, in a field survey on August, 19 95,
do hereby certify that under requirements of P.A. 74, Michigan P.A. of 1970, the corner points mentioned
in lines 1 and 2 above were in conformance with regulations and rules therefore as required in the
current manual of survey instructions of the United States Department of the Interior, Bureau of Land
Management or by a decree of a Court of Law and/or that the corner points mentioned in lines 3, 4 and 5
above were in conformance with the rules of the Michigan Board of Land Surveyors or by a Decree of a
Court of Law; established, re-established, monumented, re-monumented, recovered, found as
expressed below:

NOTE: Not more than 4 corners, all in the same town and range, may be recorded
on this certificate.

A. Description of original monument and accessories and/or subsequent restoration:

1829 - L. Lyon L.2, P.63 Government Notes
South on East line of Sec 12 T7S R19W
80.00 Set frost corner to Secs 12 & 13
Beech 11 N40W 46
Do 6 S45W 28

09/29/95

111W7821

A77

CORNER

\$9.00

09/29/95

111W7821

A77

STATE REMON FEE \$2.00

B. Description of corner evidence found and/or method applied in restoring or reestablishing corner:

May 1995


C. Barger

Found 1" Iron Pipe in gravel road
Set Witness Tag in 32" Wild Cherry S. 8°13'W. 165.7'
Set Witness Tag in 13" Wild Cherry S. 35°48'E. 29.2'
Set Witness Tag in 11" Maple N. 63°53'E. 27.8'
Set Witness Tag in 8" Ash N. 47°13'W. 35.9'
Set Witness Tag in 8" Wild Cherry S. 32°53'W. 38.8'

C. Description of monument for corner and accessories established to perpetuate locating the position of the corner:

A-5 - 1" pipe 36" long with 2 1/2" Remonumentation Brass Cap in Monument Box
Witness Tag in 32" Wild Cherry S. 8°13'W. 165.7'
Witness Tag in 13" Wild Cherry S. 35°48'E. 29.2'
Witness Tag in 11" Maple N. 63°53'E. 27.8'
Witness Tag in 8" Ash N. 47°13'W. 35.9'
Witness Tag in 8" Wild Cherry S. 32°53'W. 38.8'

And is accepted as a careful and faithful
perpetuation of the position of the original corner.

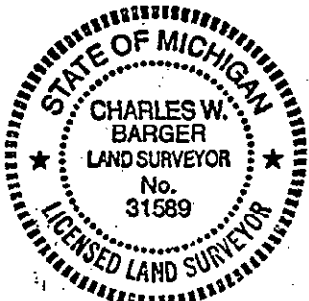

Signed by

Charles W. Barger

Date September 28, 1995

Surveyor's Michigan License No. 31589

FORM APPROVED BY MICHIGAN STATE BOARD OF LAND SURVEYORS, JAN. 28, 1971
REVISED MAY 14, 1975
REVISED JAN., 1983

LIBER

3 PAGE 244

NORTHWEST CORNER SECTION 18-7-18
SOUTHWEST CORNER SECTION 7-7-18
95512.01

(Buchanan Township - Boyle Lake Rd 1 mi. South of Glendora)

1829 L. Lyon L. 2, P. 63 Government Notes

South on East line of Sec 12 T7S R19W
80.00 Set frost corner to Secs 12 & 13
Beech 11 N40W 46
Do 6 S45W 28

Nov. 1829 W. Brookfield L. 2, P. 68 Government Notes

West between Secs 7 & 18 on random
80.10 W. Boundary 3 links N. of frost
East corrected between 7 & 18

UNKNOWN Berrien County Road Commission

Stone

Hedge West 33'
3' South of E&W fence on W. side Rd.

Oct. 1979 R. Harner

Set 1" iron from old witnesses

Old witnesses

Hedge West 33'

20" Walnut West 97.1'

22" Wild Cherry S. 9° W. 168.0'

Fence West - South 3'

UNKNOWN R. Prestine

1" Iron

Iron 33' East

8" Cherry S. 45° E. 29.3'

6" Cherry N. 45° E. 39.7'

Feb. 1993 D. Pitts

Found Iron Pipe

May, 1995 C. Barger

Found 1" Iron Pipe in gravel road

Set Witness Tag in 32" Wild Cherry S. 8° 13' W. 165.7'

Set Witness Tag in 13" Wild Cherry S. 35° 48' E. 29.2'

Set Witness Tag in 11" Maple N. 63° 53' E. 27.8'

Set Witness Tag in 8" Ash N. 47° 13' W. 35.9'

Set Witness Tag in 8" Wild Cherry S 32° 53' W. 38.8'