

RAISED BY THE COUNTY
SURVEY PEER GROUP AS THE
OFFICIAL CORNER UNDER MICHIGAN
PUBLIC ACT 345 OF 1990

RECORDED

Barrien County Remonumentation Program
LAND CORNER RECORDATION CERTIFICATE

00 OCT 16 AM 11:54

Filing Requirement of Act 74, Mich. P.A. 1970

BERNICE TRETHERWAY
REGISTER OF DEEDS
BERRIEN COUNTY, MICHIGAN

For corners in S 1/4 Post Sec 20, New Buffalo Township

Barrien (County)	Located in:	Corner Code #
1. Public Land Survey	T 8S R21W	D-9
	T R	
	T R	
	T R	
2. Property Controlling in Section	S T R	
	S T R	
3. Miscellaneous Property in Sec.	S T R	
	S T R	


10/16/00	111#4048	A66
	CORNER	\$7.00
10/16/00	111#4048	A66
	STATE REMON FEE	\$2.00

Register of Deeds Stamp & File
Number

4. Lot No. , Recorded Plat
5. Private Claims

I, Daniel B. Zwar, in a field survey on Sept. 21, 2000
do hereby state that under requirements of P.A. 74, Michigan P.A. of 1970, the
corner points mentioned in lines 1 and 2 above were in conformance with
regulations and rules therefore as required in the current manual of survey
instructions of the United States Department of the Interior, Bureau of Land
Management or by a decree of a Court of Law and /or that the corner points
mentioned in lines 3, 4 and 5 above were in conformance with the rules of the
Michigan Board of Land Surveyors or by a Decree of a Court of Law;
established, re-established, monumented, recovered, found as expressed
below:

**NOTE: Not more than 2 corners, all in the same town and range, may be recorded
on this certificate.**

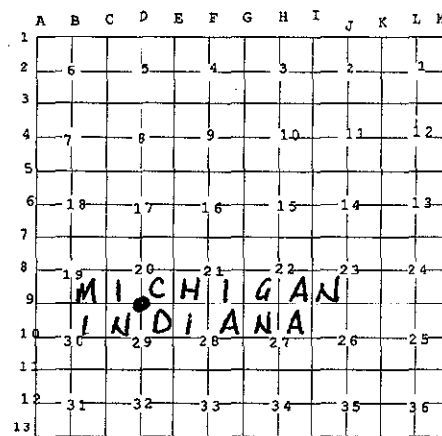

A. Description of original monument and accessories and/or subsequent restoration:

1827 - E.P. Kendricks - surveyed the N line of Indiana and set mile posts. (GLO)
1829 - L. Lyons - laid out Section 20-8-21 but did not set South 1/4 posts on state line. (GLO)

No subsequent history about this corner.

B. Description of corner evidence found and/or method applied in restoring or reestablishing corner:


1999 - D.B. Zwar - visited site - found no physical evidence except E-W fence or occupation to North. Traversed South Section line.
Measured SW Sec corner to SE Section corner 5300.82'. A straight line between them at a split of the distance falls about 5'
north of the fence. Still no evidence or occupation to North anywhere near this location. This was my recommended
position to set it and the Peer Group agreed. This position not established by original government surveyors. This location is
accepted as the best available evidence of the position of the corner.

C. Description of monument for corner and accessories established to perpetuate locating the position of the corner:

2000 - D.B. Zwar - placed a concrete monument at this on line split distance location. It's brass cap is stamped "28435 + 2000".

New Witnesses: Nail with tag in 30" Oak S21°E 7.73';
Nail with tag in 12" Oak N72°E 10.76';
Nail with tag in 24" Oak N40°W 9.80';
Nail with tag in 12" Sassafras S48°W 7.74';
Distance to SW corner Sec 20-8-21 West 2650.41';
Distance to SE corner Sec 20-8-21 East 2650.41';
Distance to N 1/4 post Sec 20-8-21 North 3660.75';
E-W fence ±5' South
Distance East to N 1/4 post Sec 9-38-3 (Indiana) stone & iron 2106.98'.

Signed by Daniel B. Zwar Date Oct 12, 2000

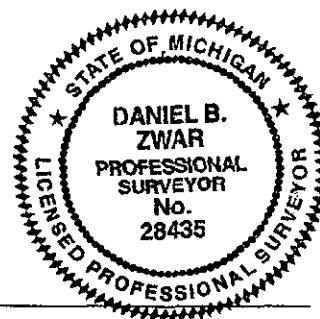

Surveyor License No. 28435

**SURVEY &
REMONUMENTATION**

JAN 31 2001

SECTION

LIBER 4

PAGE 211