

SURVEY &  
REMONUMENTATION

FEB 08 1999

SECTION

BRANCH COUNTY REMONUMATION PROGRAM  
LAND CORNER RECORDATION CERTIFICATE  
Filing Requirement of Act 74, Mich. P.A. 1970

STATE OF MICHIGAN  
Branch County  
Recorded

11-04-1998 15:45:27

Linda Lee Morrison-Mathews  
REGISTER OF DEEDS

For corners in

BRANCH COUNTY  
BUTLER TWP

Located In: Corner Code #

1. Public Land Survey T 5 S R 5 W A-3  
T R  
T R  
T R

2. Property Controlling S T R  
in Section S  
T R

3. Miscellaneous S  
T R

Property in Sec. S  
T R

Register of Deeds Stamp & File Number

4. Lot No. , Recorded Plat  
5. Private Claims

I, EDWARD W. REED, in a field survey on AUGUST 28, 1998 do hereby state that under requirements of P.A. 74, Michigan P.A. of 1970, the corner points mentioned in lines 1 and 2 above were in conformance with regulations and rules therefore as required in the current manual of survey instructions of the United States Department of the Interior, Bureau of Land Management or by a decree of a Court of Law and for that the corner points mentioned in lines 3, 4 and 5 above were in conformance with the rules of the Michigan Board of Land Surveyors or by a Decree of a Court of Law; established, re-established, monumented, recovered, found as expressed below:

NOTE: Not more than 2 corners, all in the same town and range, may be recorded on this certificate.

SOUTHWEST CORNER SECTION 6, NORTHWEST CORNER SECTION 7

A. Description of original monument and accessories and/or subsequent restoration:  
1825: R. CLARK, JR., D.S. - CORNER SET  
1878: M. KNOWLES, CO SURVEYOR - FOUND CORNER PERPETUATED BY STAKE & STONE  
1907: CHAS HAMILTON, CO SURVEYOR - FOUND STONE  
1977: E.R. REED, CO SURVEYOR - FOUND STONE & CROCKERY  
1978: R. CUTCHER, SURVEYOR - FOUND 3 LARGE STONES, SET 1/2" IRON ON TOP, TIED SURVEY TO CORNER

ACCEPTED BY THE BRANCH COUNTY  
SURVEY PEER GROUP AS THE OFFICIAL  
CORNER UNDER MICHIGAN PUBLIC ACT 345  
OF 1930 AT A MEETING HELD ON  
9-09-1998

E.R. Reed, Co. Rep.  
E.R. REED

B. Description of corner evidence found and/or method applied in restoring or reestablishing corner:

FOUND 1/2" X 24" CAPPED IRON ON TOP OF 3 STONES FITTING WITNESS OF CUTCHER

C. Description of monument for corner and accessories established to perpetuate locating the position of the corner:

SET REMON CAP ON IRON, SET CI-MONUMENT BOX FLUSH WITH PAVED ROAD SURFACE

15.3' NORTH OF E-W ROAD


TWIN 12" SYC.	S 30 W	67.05' TO N & C
23" OAK	S 10 E	44.94' TO N & C
FENCE COR. POST	N 70 E	35.14' TO N & C
TRIANGLE CONC POST	N 60 W	35.85'
TEL PED	S 29 W	46.8' TO FACE
ROAD CULVERT	N 80 W	50.25' TO TOP CENTER

AND IS ACCEPTED AS A CAREFUL AND FAITHFUL PERPETUATION OF THE POSITION OF THE ORIGINAL CORNER.

Signed by Edward W. Reed  
EDWARD W. REED

Date 9-9-98

Surveyor's Michigan License No. 33985

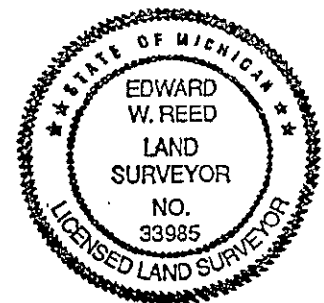

Liber 000003 Page 0205