

SURVEY &
REMONUMENTATION

MAR 21 1997

COMMISSION

BRANCH COUNTY REMONUMENTATION CORNER
LAND CORNER RECORDATION CERTIFICATE
Filing Requirement of Act 74, Mich. P.A. 1970

Liber 000003 Page 0073

For corners in

BRANCH
(County)

Located In:

Corner Code #

GILEAD TWP.

1. Public Land Survey

T 8S R 7W

C-4

T R

T R

T R

2. Property Controlling
in Section

S T R

S T R

3. Miscellaneous
Property in Sec.

S T R

S T R

4. Lot No. , Recorded Plat

5. Private Claims

STATE OF MICHIGAN
Branch County
Recorded

10-30-1996 09:19:48

Linda Lee Morrison-Mathews
REGISTER OF DEEDS

Register of Deeds Stamp & File Number

I, Edward W. Reed, in a field survey on JULY 5, 19 96

do hereby certify that under requirements of P.A. 74, Michigan P.A. of 1970, the corner points mentioned in lines 1 and 2 above were in conformance with regulations and rules therefore as required in the current manual of survey instructions of the United States Department of the Interior, Bureau of Land Management or by a decree of a Court of Law and/or that the corner points mentioned in lines 3, 4 and 5 above were in conformance with the rules of the Michigan Board of Land Surveyors or by a Decree of a Court of Law; established, re-established, monumented, re-monumented, recovered, found as expressed below:

NOTE: Not more than 4 corners, all in the same town and range, may be recorded on this certificate.

A. Description of original monument and accessories and/or subsequent restoration:

QUARTER CORNER COMMON TO SECTIONS 7 & 8, GILEAD TWP., T8S, R7W, BRANCH COUNTY, MI

1825: R. CLARK, JR., DEP. SURVEYOR, SET CORNER

1893: C. HAMILTON, DEP. COUNTY SURVEYOR-CORNER GONE-RELOCATED ACCORDING TO STATUTE-PLANTED LIGHT COLORED STONE-DEPOSIT OF EARTHEN, GLASS & BRICK

1945: HAROLD RUSSELL, COUNTY SURVEYOR, FOUND STONE SET BY HAMILTON

1975: E.R. REED, COUNTY SURVEYOR, STONE NOW GONE DUE TO ROAD REBUILDING OPERATION

RESET CORNER FROM OLD WITNESS-SET 36" LONG IRON IN CAST IRON BOX-RECORDED IN L.C.R.#144

B. Description of corner evidence found and/or method applied in restoring or reestablishing corner:

FOUND IRON ROD IN CAST IRON MONUMENT BOX

SET 1/2" x 18" IRON ALONG SIDE AND REMONUMENTATION CAP OVER IRON BAR

RAISED TO ROAD SURFACE WITH 1 SMALL RING ON CAST IRON BOX

ACCEPTED BY THE BRANCH COUNTY
SURVEY PEER GROUP AS THE OFFICIAL
CORNER UNDER MICHIGAN PUBLIC ACT 345
OF 1990 AT A MEETING HELD ON
OCT. 9, 1996

E.R. Reed Co. Rep.
E.R. REED

C. Description of monument for corner and accessories established to perpetuate locating the position of the corner:

1/2" x 18" IRON WITH REMONUMENTATION CAP IN CAST IRON BOX

S60W 41.6' TO CENTER OF 12" BLACK WALNUT


S59W 37.5' TO NE CORNER OF 16" SQ. CONCRETE ANCHOR POST

S23E 50.4' TO CENTER OF 12" WALNUT

S50E 36.0' TO RR-RAIL ANCHOR POST

S70E 75.0' TO CENTER OF 36" WALNUT

N45E 42.8' TO CENTER OF 24" SQ. CONCRETE ANCHOR POST

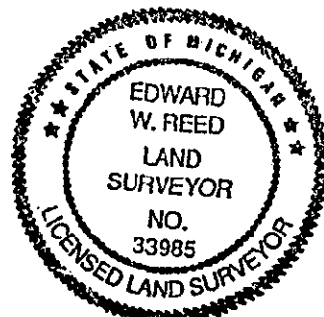

And is accepted as a careful and faithful perpetuation of the position of the original corner.

Signed by Edward W. Reed

Date JULY 5, 1996

Surveyor's Michigan License No. 33985