

# SURVEY & REMONUMENTATION

1993

CALHOUN COUNTY REMONUMENTATION

COMMISSION

## LAND CORNER RECORDATION CERTIFICATE Filing Requirement of Act 74, Mich. P.A. 1970

RECORDED

Nov 19 1 00 PM 93

For corners in

CALHOUN

(County)

Located In:

Corner Code #

- |                                    |   |   |   |   |   |   |      |
|------------------------------------|---|---|---|---|---|---|------|
| 1. Public Land Survey              | T | 1 | S | R | 4 | W | G-13 |
|                                    | T |   |   | R |   |   |      |
|                                    | T |   |   | R |   |   |      |
|                                    | T |   |   | R |   |   |      |
| 2. Property Controlling in Section | S |   | T |   | R |   |      |
|                                    | S |   | T |   | R |   |      |
| 3. Miscellaneous Property in Sec.  | S |   | T |   | R |   |      |
|                                    | S |   | T |   | R |   |      |

CLERK-REGISTRAR  
CALHOUN COUNTY  
ANNA H. MCNEIL

Register of Deeds Stamp & File Number

4. Lot No. \_\_\_\_\_, Recorded Plat \_\_\_\_\_
5. Private Claims \_\_\_\_\_

I, Donald J. Davis, in a field survey on October 27, 19 93, do hereby certify that under requirements of P.A. 74, Michigan P.A. of 1970, the corner points mentioned in lines 1 and 2 above were in conformance with regulations and rules therefore as required in the current manual of survey instructions of the United States Department of the Interior, Bureau of Land Management or by a decree of a Court of Law and/or that the corner points mentioned in lines 3, 4 and 5 above were in conformance with the rules of the Michigan Board of Land Surveyors or by a Decree of a Court of Law; established, re-established, monumented, re-monumented, recovered, found as expressed below:

**NOTE: Not more than 4 corners, all in the same town and range, may be recorded on this certificate.**

A. Description of original monument and accessories and/or subsequent restoration:

Tile set in resurvey from Sheridan corner to East.

12" White Oak N 34½° E 31 Links. Gone

9" Hickory S 81° W 203 Links. Gone.

Reset R.R. Spike in December 1973 by Davis from old stump of Oak N 34° E 31 Links. (20.46')

B. Description of corner evidence found and/or method applied in restoring or reestablishing corner:

Found R.R. Spike as used in previous surveys by Davis and D. Bissell of D.N.R.  
Original corner destroyed by road construction.

Accepted this as local reestablishment of the original location.

	A	B	C	D	E	F	G	H	I	J	K	L	M
2	6		5		4		3		2		1		
3													
4	7		8		9		10		11		12		
5													
6	18		17		16		15		14		13		
7													
8	19		20		21		22		23		24		
9													
10	30		29		28		27		26		25		
11													
12	31		32		33		34		35		36		
13													

C. Description of monument for corner and accessories established to perpetuate locating the position of the corner:

Set Berntsen monument in monument box.


Nail & Tag Utility pole N 65° E 113.34'

Nail & Tag Utility pole S 60° E 114.25'

Nail & Tag Utility pole S 20° E 61.03'

Nail & Tag 20" Maple N 35° W 129.08'

54.78' West of Sheridan Corner.

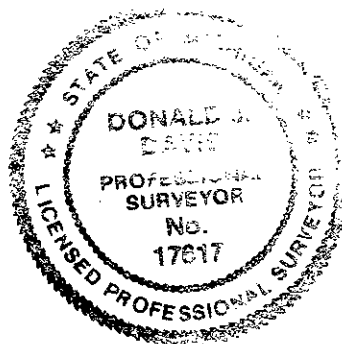

Signed by

*Donald J. Davis*

Date November 3, 1993

Surveyor's Michigan License No. 17617