

APPROVED

Date 8-18-99 RRC

CALHOUN COUNTY
REMONUMENTATION.

CALHOUN COUNTY REMONUMENTATION
LAND CORNER RECORDATION CERTIFICATE
Filing Requirement of Act 74, Mich. P.A. 1970

For corners in

Calhoun (County)	Located In:	Corner Code #
Lee Township	T___ R___	___
1. Public Land Survey	T___ R___	___
	T___ R___	___
	T___ R___	___
2. Property Controlling in Section	S 30 T 1S R 5W	001
	S___ T___ R___	___
3. Miscellaneous Property in Sec.	S___ T___ R___	___
	S___ T___ R___	___

SURVEY &
REMONUMENTATION

SEP 20 1999

SECTION

STATE OF MICHIGAN
CALHOUN COUNTY
RECORDED

8 SEP 1999 9:56:54 AM

ANNE B. NORLANDER
CLERK - REGISTER OF DEEDS

Lined 2158 Doc 003
Register of Deeds Stamp & File Number

4. Lot No. _____, Recorded Plat _____
5. Private Claims _____

I, William K. Crane, in a field survey on August 3, 1999 do hereby state that under requirements of P.A. 74, Michigan P.A. of 1970, the corner points mentioned in lines 1 and 2 above were in conformance with regulations and rules therefore as required in the current manual of survey instructions of the United States Department of the Interior, Bureau of Land Management or by a decree of a Court of Law and for that the corner points mentioned in lines 3, 4 and 5 above were in conformance with the rules of the Michigan Board of Land Surveyors or by a Decree of a Court of Law, established, re-established, monumented, recovered, found as expressed below:

NOTE: Not more than 2 corners, all in the same town and range, may be recorded on this certificate.

	A	B	C	D	E	F	G	H	I	J	K	L	M
1													
2		6		5		4		3		2		1	
3													
4		7		8		9		10		11		12	
5													
6		18		17		16		15		14		13	
7													
8		19		20		21		22		23		24	
9													
10		30		29		28		27		26		25	
11													
12		31		32		33		34		35		36	
13													

A. Description of original monument and accessories and/or subsequent restoration:

Government Meander Corner set by Sibley, 1826, at 1.50 chains West of Northeast Corner position.

7" Tamarack N 82° W 51 links
4" DO S 25° W 48 links


B. Description of corner evidence found and/or method applied in restoring or reestablishing corner:

Found Berntsen Monument, set by Don Davis, 35.58 feet West of East line of Section 30, as a reference monument to the Meander Corner. The reference monument is located 64.63 feet East of the prorated location for the Government Meander Corner.

C. Description of monument for corner and accessories established to perpetuate locating the position of the corner:

Found Standard Calhoun County Remonumentation Monument set as a reference monument to the Government Meander Corner.

12" Triple Maple S 15° W 39.10'
18" Triple Maple N 82° W 28.65'
10" Maple N 46° W 43.23'
10" Twin Maple N 54° W 85.03'

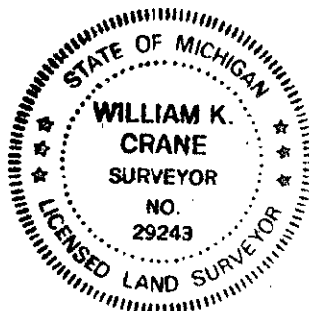

Signed by William K. Crane Date September 2, 1999

William K. Crane, P.S.

Surveyor's Michigan License No. 29243