

APPROVED

Date 8-18-99 AKC
CALHOUN COUNTY
REMONUMENTATION.

CALHOUN COUNTY REMONUMENTATION
LAND CORNER RECORDATION CERTIFICATE
Filing Requirement of Act 74, Mich. P.A. 1970

SURVEY &
REMONUMENTATION

SEP 20 1999

SECTION

STATE OF MICHIGAN
CALHOUN COUNTY
RECORDED

8 SEP 1999 9:57:05 AM

ANNE B. NORLANDER
CLERK - REGISTER OF DEEDS

LIBER 2158 PAGE 994

Register of Deeds Stamp & File Number

For corners in

<u>Calhoun</u> (County)	Located In:	Corner Code #
Lee Township		
1. Public Land Survey	T <u> </u> R <u> </u>	<u> </u>
	T <u> </u> R <u> </u>	<u> </u>
	T <u> </u> R <u> </u>	<u> </u>
	T <u> </u> R <u> </u>	<u> </u>
2. Property Controlling in Section	S <u>30</u> T <u>1S</u> R <u>5W</u>	<u>002</u>
	S <u> </u> T <u> </u> R <u> </u>	<u> </u>
3. Miscellaneous Property in Sec.	S <u> </u> T <u> </u> R <u> </u>	<u> </u>
	S <u> </u> T <u> </u> R <u> </u>	<u> </u>

4. Lot No. , Recorded Plat
5. Private Claims

I, William K. Crane, in a field survey on August 3, 1999 do hereby state that under requirements of P.A. 74, Michigan P.A. of 1970, the corner points mentioned in lines 1 and 2 above were in conformance with regulations and rules therefore as required in the current manual of survey instructions of the United States Department of the Interior, Bureau of Land Management or by a decree of a Court of Law and/or that the corner points mentioned in lines 3, 4 and 5 above were in conformance with the rules of the Michigan Board of Land Surveyors or by a Decree of a Court of Law; established, re-established, monumented, recovered, found as expressed below:

NOTE: Not more than 2 corners, all in the same town and range, may be recorded on this certificate.

	A	B	C	D	E	F	G	H	I	J	K	L	M
1													
2		6		5		4		3		2		1	
3													
4		7		8		9		10		11		12	
5													
6		18		17		16		15		14		13	
7													
8		19		20		21		22		23		24	
9													
10		30		29		28		27		26		25	
11													
12		31		32		33		34		35		36	
13													

A. Description of original monument and accessories and/or subsequent restoration:

Government Meander Corner set by Sibley, 1826, at 77.50 chains North of Southeast Corner Section 30.

7" Tamarack N 55-1/2° W 44 links
5" DO S 25° W 32 links


B. Description of corner evidence found and/or method applied in restoring or reestablishing corner:

Found Bernsen Monument, set by Don Davis, 115.52 feet South of North line of Section 30, as a reference monument to the Meander Corner. The reference monument is located 49.73 feet North of the prorated location for the Government Meander Corner.

C. Description of monument for corner and accessories established to perpetuate locating the position of the corner:

Found Standard Calhoun County Remonumentation Monument set as a reference monument to the Government Meander Corner.

12" Triple Maple S 15° W 39.10'
18" Triple Maple N 62° W 28.65'
10" Maple N 46° W 43.23'
10" Twin Maple N 54° W 65.03'

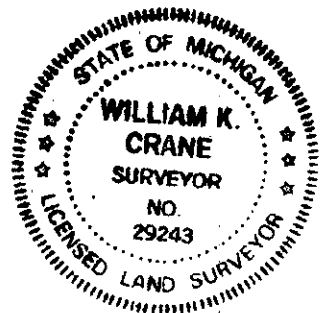

Signed by William K. Crane
William K. Crane, P.S.

Date September 2, 1999

Surveyor's Michigan License No. 29243