

APPROVED

CALHOUN COUNTY  
REMONUMENTATION

For corners in

CALHOUN  
(County)

Located In:

Corner Code =#

CALHOUN COUNTY REMONUMENTATION

LAND CORNER RECORDATION CERTIFICATE

Filing Requirement of Act 74, Mich. P.A. 1970

RECORDED

MAR 24 11 07 AM '94

CLERK-REGISTER  
CALHOUN COUNTY, MICH.  
ANNE B. NORLANDER

SURVEY &  
REMONUMENTATION

OCT 27 1994

Register of Deeds Stamp & File Number

1. Public Land Survey

T 1S R 7W A-1  
T 1S R 8W M-1  
T R  
T R  
S T R  
S T R  
S T R  
S T R

2. Property Controlling  
in Section

3. Miscellaneous  
Property in Sec.

4. Lot No. , Recorded Plat

5. Private Claims

I, BRIAN REYNOLDS, in a field survey on MARCH 8TH, 19 94,  
do hereby certify that under requirements of P.A. 74, Michigan P.A. of 1970, the corner points mentioned  
in lines 1 and 2 above were in conformance with regulations and rules therefore as required in the  
current manual of survey instructions of the United States Department of the Interior, Bureau of Land  
Management or by a decree of a Court of Law and/or that the corner points mentioned in lines 3, 4 and 5  
above were in conformance with the rules of the Michigan Board of Land Surveyors or by a Decree of a  
Court of Law; established, re-established, monumented, re-monumented, recovered, found as  
expressed below:

**NOTE: Not more than 4 corners, all in the same town and range, may be recorded  
on this certificate.**

A. Description of original monument and accessories and/or subsequent restoration:

GENERAL LAND OFFICE

78.50 INTERSECT BASE LINE

EAST OF POST T1N RANGE 7&8 WEST

W. OAK 18 N31W 21

Do 10 S76E 52

JOHN MULLETT DEC. 14, 1825

RESURVEY BY GIFFORD 1891

Y. OAK 16" N13E 58 LKS

W. OAK 30" S 28 1/2W 21 LKS

CHASE, DeKEYSER AND ALDEN FOR CONSUMER'S POWER  
COMPANY C. 1965 FOUND TILE WITH IRON ABOVE, 2'  
EAST OF FENCE SOUTH & IN C/L OF GRAVEL ROAD E & W  
6" OAK N75°W 68.2'  
12" OAK N70°E 85.1'  
12" OAK S80°E 183.8'

B. Description of corner evidence found and/or method applied in restoring or reestablishing corner:

ROAD HAS BEEN REBUILT SINCE CONSUMERS POWER CO. SURVEY, GRADE IS SEVERAL FEET LOWER, LEAVING  
NO POSSIBILITY OF RECOVERY OF TILE. ONE WITNESS TREE REMAINS, VIS. OAK S80°E 183.8' NOW MUCH  
LARGER. FOUND A-13 AND B-13 OF T1N, R7W. ALSO FOUND M-2 AND "N1/8 CORNER ON E LINE OF  
SECTION 1 "T1S R8W AS DESCRIBED BY CONSUMER'S POWER SURVEY, AND CORRESPONDING CLOSING CORNERS.  
PROJECTED LINE THROUGH TO INTERSECT BASE LINE, INTERSECT POINT FELL 0.04' WEST OF PRORATED  
GOVERNMENT JOG. SET STANDARD CALHOUN COUNTY MONUMENT AND MONUMENT BOX AT INTERSECTION, POINT  
FITS WITH REMAINING WITNESS TREE FOR BEARING AND DISTANCE.

LIBER 1738 PAGE 167

C. Description of monument for corner and accessories established to perpetuate locating the position of the corner:

WITNESSES TO STANDARD CALHOUN COUNTY MONUMENT IN CASTING

NAIL & WITNESS TAG N. SIDE 10" OAK S80E 181.77


NAIL & WITNESS TAG N'LY SIDE 15" OAK S65E 97.97

NAIL NW SIDE UTILITY POLE S25W 50.93

NAIL & WITNESS TAG IN W SIDE 15" MAPLE S20E 59.34

NAIL & WITNESS TAG S. SIDE UTILITY POLE N70W 83.14

NW CORNER FRAME GARAGE S70W 192.23

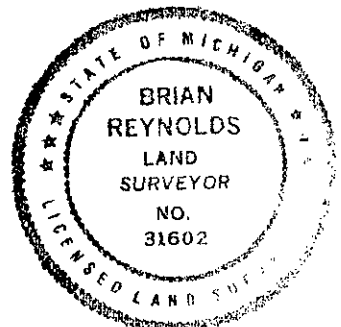

Signed by

Date

MARCH 15, 1994

Surveyor's Michigan License No.

31602