

APPROVED

Date 8-17-94 DJM

CALHOUN COUNTY
REMONUMENTATION.

For corners in

CALHOUN
(County)

ECKFORD TWP

1. Public Land Survey

Located In:

Corner Code =#

T 3 S R 5 W

J-3

T R

T R

T R

2. Property Controlling
in Section

S T R

S T R

3. Miscellaneous
Property in Sec.

S T R

S T R

4. Lot No. , Recorded Plat

5. Private Claims

I, ROBERT R. CARR, in a field survey on JUNE 3, 19 94, do hereby certify that under requirements of P.A. 74, Michigan P.A. of 1970, the corner points mentioned in lines 1 and 2 above were in conformance with regulations and rules therefore as required in the current manual of survey instructions of the United States Department of the Interior, Bureau of Land Management or by a decree of a Court of Law and/or that the corner points mentioned in lines 3, 4 and 5 above were in conformance with the rules of the Michigan Board of Land Surveyors or by a Decree of a Court of Law; established, re-established, monumented, re-monumented, recovered, found as expressed below:

NOTE: Not more than 4 corners, all in the same town and range, may be recorded on this certificate.

A. Description of original monument and accessories and/or subsequent restoration:

ORIGINAL CORNER SET BY DEPUTY SURVEYOR, LYON 1826
USED BY COUNTY SURVEYOR B.F. WELLS 10/04/1879
NO WITNESSES RECORDED

SURVEY &
REMONUMENTATION

OCT 24 1994

COMMISSION


B. Description of corner evidence found and/or method applied in restoring or reestablishing corner:

FOUND 1/2" IRON STAKE IN MONUMENT BOX OVER LARGE SPIKE OVER 1" BAR WITH STONE,
BRICKS & POTTERY
REPLACED WITH BERNTSEN MONUMENT IN MONUMENT BOX WITH STONE, BRICKS & POTTERY AROUND

C. Description of monument for corner and accessories established to perpetuate locating the position of the corner:

BERNTSEN MONUMENT
NAIL & SPOTTER NORTHERLY SIDE 10" MAPLE S65°W 45.54 FT.
NAIL & SPOTTER WESTERLY SIDE 10" MAPLE S22°E 25.31 FT
NAIL & SPOTTER SOUTHERLY SIDE 24" MAPLE N62°W 72.83 FT.
NAIL & SPOTTER SOUTHERLY SIDE TWIN 8" & 10" LOCUST N75°E 91.82 FT
IN LINE WITH FENCE LINE TO NORTH
4.5'± SOUTH OF CENTERLINE OF EAST/WEST ROAD

LIBER 1763 PAGE 775

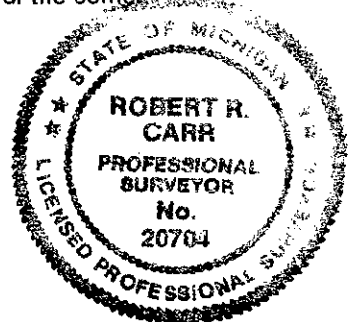

Signed by

Robert R. Carr

Date

AUGUST 16, 1994

Surveyor's Michigan License No. ROBERT R. CARR

20704