

MAR 30 1999

APPROVED

Date 10-29-98 RLL

CALHOUN COUNTY
REMONUMENTATION

CALHOUN COUNTY REMONUMENTATION
LAND CORNER RECORDATION CERTIFICATE
Filing Requirement of Act 74, Mich. P.A. 1970

STATE OF MICHIGAN
CALHOUN COUNTY
RECORDED

For corners in

Calhoun	Located in:	Corner Code #
(County)		
Fredonia		
1. Public Land Survey	T3S R6W	G-5
	T R	
	T R	
	T R	
2. Property Controlling in Section	S T R	
	S T R	
3. Miscellaneous Property in Sec.	S T R	
	S T R	

29 OCT 1998 2:42:13 PM

APPE D. NORLINDER
CLERK - REGISTER OF DEEDS

LIBER 2073 PAGE 286

Register of Deeds Stamp & File Number

4. Lot No. _____, Recorded Plat _____
5. Private Claims _____

I, Michael A. Groat, in a field survey on October 8, 1998 do hereby state that under requirements of P.A. 74, Michigan P.A. of 1970, the corner points mentioned in lines 1 and 2 above were in conformance with regulations and rules therefore as required in the current manual of survey instructions of the United States Department of the Interior, Bureau of Land Management or by a decree of a Court of Law and/or that the corner points mentioned in lines 3, 4 and 5 above were in conformance with the rules of the Michigan Board of Land Surveyors or by a Decree of a Court of Law; established, re-established, monumented, recovered, found as expressed below:

NOTE: Not more than 2 corners, all in the same town and range, may be recorded on this certificate.

	A	B	C	D	E	F	G	H	I	J	K	L	M
1													
2	6		5		4		3		2		1		
3													
4	7		8		9		10		11		12		
5													
6	18		17		16		15		14		13		
7													
8	19		20		21		22		23		24		
9													
10	30		29		28		27		26		25		
11													
12	31		32		33		34		35		36		
13													

A. Description of original monument and accessories and/or subsequent restoration:


ORIGINAL SURVEY BY LUCIUS LYON, 1825, SET POST, W. OAK, 14", S 25°W, 28 LKS.
MAPLE, 23", S 74° E, 24 LKS.
1973, C. PIKE, P.S., FOUND POINTED ROCK W/CIRCLE OF STONES AROUND, 5.3' W OF N & S
FENCE, 6" ASH, N 40° W, 4.90'; 6" TWIN MAPLE, N 80° E, 5.2'. 166° SOUTH AT 12"X12"X8" ROCK ON
SOUTH EDGE OF STREAM.

B. Description of corner evidence found and/or method applied in restoring or reestablishing corner:

FOUND 1" PIPE IN CIRCLE OF STONES. MATCHED REMAINING WITNESSES FROM PIKE. SET
BERNTSEN MONUMENT IN PLACE OF PIPE.

C. Description of monument for corner and accessories established to perpetuate locating the position of the corner:

BERNTSEN MONUMENT WITH CARSONITE MARKER 15' WEST OF N & S FENCE
4' WEST OF N & S FENCE
"BOELTER PROPERTY CORNER", SE, 0.30'
NAIL & TAG IN 8" WALNUT, S 48° W, 4.75'
NAIL & TAG IN 24" W OAK, N 35° E, 24.55'
NAIL & TAG IN 15' HICKORY, N 60° W, 30.75'
NAIL & TAG IN 10" MAPLE, N 75° E, 4.85'

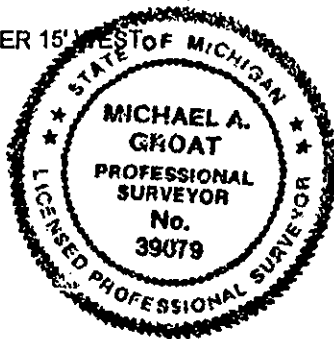

Signed by

Michael A. Groat

Date October 8, 1998

Surveyor's Michigan License No. 39079