

# SURVEY & REMONUMENTATION

MAR 13 2000

APPROVED

Date 10-20-99 RRL  
CALHOUN COUNTY  
REMONUMENTATION.

SECTION  
CALHOUN COUNTY REMONUMENTATION  
LAND CORNER RECORDATION CERTIFICATE  
Filing Requirement of Act 74, Mich. P.A. 1970

For corners in

Calhoun  
(County)  
Fredonia Township  
1. Public Land Survey

Located In:

Corner Code #

2. Property Controlling  
in Section  
3. Miscellaneous  
Property in Sec.

T	3S	R	6W	J-9
T		R		
T		R		
T		R		
S		T		
S		T		
S		T		
S		T		

STATE OF MICHIGAN  
CALHOUN COUNTY  
RECORDED

3 DEC 1999 2:38:15 PM

ANNE B. NORLANDER  
CLERK - REGISTER OF DEEDS  
LIBER 2182 PAGE 413

Register of Deeds Stamp & File Number

4. Lot No. \_\_\_\_\_, Recorded Plat \_\_\_\_\_  
5. Private Claims \_\_\_\_\_

I, William K. Crane, in a field survey on October 14, 1999 do hereby state that under requirements of P.A. 74, Michigan P.A. of 1970, the corner points mentioned in lines 1 and 2 above were in conformance with regulations and rules therefore as required in the current manual of survey instructions of the United States Department of the Interior, Bureau of Land Management or by a decree of a Court of Law and for that the corner points mentioned in lines 3, 4 and 5 above were in conformance with the rules of the Michigan Board of Land Surveyors or by a Decree of a Court of Law; established, re-established, monumented, recovered, found as expressed below:

NOTE: Not more than 2 corners, all in the same town and range, may be recorded on this certificate.

	A	B	C	D	E	F	G	H	I	J	K	L	M
1													
2	6		5		4		3		2		1		
3													
4	7		8		9		10		11		12		
5													
6	18		17		16		15		14		13		
7													
8	19		20		21		22		23		24		
9													
10	30		29		28		27		26		25		
11													
12	31		32		33		34		35		36		
13													

A. Description of original monument and accessories and/or subsequent restoration:

G.L.O. Lucius Lyon, 1825:  
26" b. oak N 55° E 1.31 links  
N 45° E 6 links  
7" w. oak S 45° E 90 links

Lewis, 1882:  
9" y. oak

Set post by prorating the distance between the meander posts

Corner is tied to the plat of Lyon Lake Woods in Section 23, recorded in liber 10 of plats, on page 10.


B. Description of corner evidence found and/or method applied in restoring or reestablishing corner:

Found no physical evidence of corner. Traversed to some lot corners and plat monuments in the plat of Lyon Lake Woods, computed section corner location and dug large area looking for corner. No occupation running North or South, but fit occupation running East and West. Set corner at location computed from plat.

C. Description of monument for corner and accessories established to perpetuate locating the position of the corner:

Set standard Calhoun County Remonumentation monument (Berntsen monument) and is accepted as the best available evidence of the position of the original corner.

Nail & tag in 16" sassafras	West	1.10'
Nail & tag in 16" sassafras	East	2.68'
Nail & tag in 12" red pine	N 20° E	75.57'
Nail & tag in 12" red pine	N 10° W	60.65'

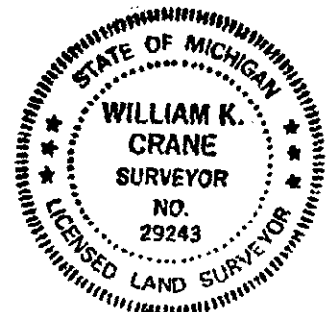

Signed by William K. Crane  
William K. Crane, P.S.

Date October 25, 1999

Surveyor's Michigan License No. 29243