

SURVEY & REMONUMENTATION

MAR 21 1997

COMMISSION

APPROVED

ate SEPT 18 1996
CALHOUN COUNTY
EMONUMENTATION.

CALHOUN COUNTY REMONUMENTATION

LAND CORNER RECORDATION CERTIFICATE
Filing Requirement of Act 74, Mich. P.A. 1970

For corners in

Calhoun	Located In:	Corner Code #
(County)		
Fredonia Township		
1. Public Land Survey	T <u>3</u> S R <u>6</u> W	<u>K-2</u>
	T <u> </u> R <u> </u>	<u> </u>
	T <u> </u> R <u> </u>	<u> </u>
	T <u> </u> R <u> </u>	<u> </u>
2. Property Controlling in Section	S <u> </u> T <u> </u> R <u> </u>	<u> </u>
	S <u> </u> T <u> </u> R <u> </u>	<u> </u>
3. Miscellaneous Property in Sec.	S <u> </u> T <u> </u> R <u> </u>	<u> </u>
	S <u> </u> T <u> </u> R <u> </u>	<u> </u>

STATE OF MICHIGAN
CALHOUN COUNTY
RECORDED

24 SEP 96 11:00 A.M.

ANNE B. NORLANDER
CLERK - REGISTER OF DEEDS

Register of Deeds Stamp & File Number

4. Lot No. , Recorded Plat
5. Private Claims

I, Michael A. Groat, in a field survey on August 9, 19 96, do hereby state that under requirements of P.A. 74, Michigan P.A. of 1970, the corner points mentioned in lines 1 and 2 above were in conformance with regulations and rules therefore as required in the current manual of survey instructions of the United States Department of the Interior, Bureau of Land Management or by a decree of a Court of Law and/or that the corner points mentioned in lines 3, 4 and 5 above were in conformance with the rules of the Michigan Board of Land Surveyors or by a Decree of a Court of Law, established, re-established, monumented, recovered, found as expressed below:

NOTE: Not more than 2 corners, all in the same town and range, may be recorded on this certificate.

	A	B	C	D	E	F	G	H	I	J	K	L	M
1													
2	6		5			4		3		2		1	
3													
4	7		8		9		10		11		12		
5													
6	18		17		16		15		14		13		
7													
8	19		20		21		22		23		24		
9													
10	30		29		28		27		26		25		
11													
12	31		32		33		34		35		36		
13													

A. Description of original monument and accessories and/or subsequent restoration:

G.L.O. Survey - 1825 by Lucius Lyon

No re-survey was made

B. Description of corner evidence found and/or method applied in restoring or reestablishing corner:

Found 1/2" iron with Arthur Brintnall, P.S. #28407, 29.6' West of the centerline of Old U.S. 27. The corner has been used by local surveyors for several years. Accepted the position of the iron as the best perpetuation of the original corner and set a Berntsen Monument in its place.

C. Description of monument for corner and accessories established to perpetuate locating the position of the corner:

Set Berntsen Monument with carsonite marker beside.

Witnesses:

29.6' West of the centerline of Old U.S. 27 on the South edge of a creek.

Nail and spotter in 30' Maple, N 45° E, 129.2'

Nail and spotter in 10' Walnut, S 30° W, 59.5'

Nail and spotter in 10' Cedar, N 30° E, 146.2'


Nail and spotter in 10' Cedar, S 20° E, 143.1'

LIBER 1887 PAGE 979

Signed by

Date 9-18-96

Surveyor's Michigan License No.

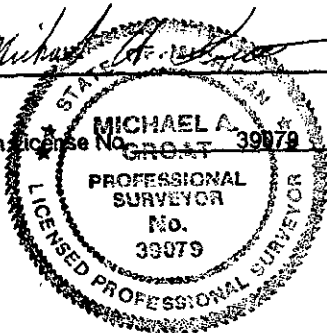

FORM APPROVED BY MICHIGAN STATE BOARD OF PROFESSIONAL SURVEYORS, JAN. 28, 1971
REVISED MAY 14, 1975
REVISED JAN., 1988
REVISED OCT., 1988