

1993

CALHOUN COUNTY REMONUMENTATION

COMMISSION

LAND CORNER RECORDATION CERTIFICATE
Filing Requirement of Act 74, Mich. P.A. 1970

RECORDED
Oct 26 10 25 AM '93
CLERK-REGISTER
CALHOUN COUNTY, MICH
ANNE B. MORLANDER

For corners in
Calhoun

(County)

Located In:

Corner Code ##

- | | | |
|---------------------------------------|---------------------------|------------|
| 1. Public Land Survey | T <u>4S.</u> R <u>5W.</u> | <u>L-3</u> |
| | T _____ R _____ | _____ |
| | T _____ R _____ | _____ |
| | T _____ R _____ | _____ |
| | T _____ R _____ | _____ |
| 2. Property Controlling
in Section | S _____ T _____ R _____ | _____ |
| | S _____ T _____ R _____ | _____ |
| 3. Miscellaneous
Property in Sec. | S _____ T _____ R _____ | _____ |
| | S _____ T _____ R _____ | _____ |

Register of Deeds Stamp & File Number

4. Lot No. _____, Recorded Plat _____
5. Private Claims _____

	A	B	C	D	E	F	G	H	I	J	K	L	M
2	6		5		4		3		2		1		
3													
4	7		8		9		10		11		12		
5													
6	18		17		16		15		14		13		
7													
8	19		20		21		22		23		24		
9													
10	30		29		28		27		26		25		
11													
12	31		32		33		34		35		36		
13													

Frederick J.

I, Cutcher, in a field survey on October 15, 19 93,
do hereby certify that under requirements of P.A. 74, Michigan P.A. of 1970, the corner points mentioned
in lines 1 and 2 above were in conformance with regulations and rules therefore as required in the
current manual of survey instructions of the United States Department of the Interior, Bureau of Land
Management or by a decree of a Court of Law and/or that the corner points mentioned in lines 3, 4 and 5
above were in conformance with the rules of the Michigan Board of Land Surveyors or by a Decree of a
Court of Law; established, re-established, monumented, re-monumented, recovered, found as
expressed below:

**NOTE: Not more than 4 corners, all in the same town and range, may be recorded
on this certificate.**


- A. Description of original monument and accessories and/or subsequent restoration:
Corner common to Sections 1 & 12, Town 4 South, Range 5 West.

M.S.H.D. 1963: T-Beam 5" above ground.

Liber 1123, Page 254 of Land Corner Records rec'd June 20, 1977: 4" x 4" tee iron;
N 10° W 211' S. edge of pv't M-60; due East broken fence cor. 97'; N 30° E 4' tall RR
track 198.5'.

- B. Description of corner evidence found and/or method applied in restoring or reestablishing corner:

Found 4" x 4" tee iron according to above references.

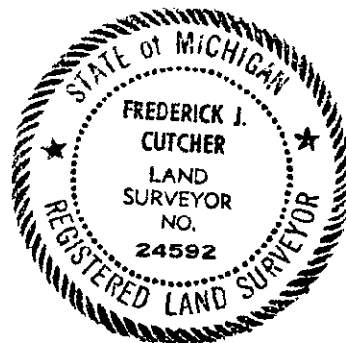

- C. Description of monument for corner and accessories established to perpetuate locating the position of the corner:

Replaced 4" x 4" tee iron with Bernsten Stainless Steel Marker with Bronze Cap. Set
4" x 4" tee iron on S.E. side. $\frac{1}{2}$ " x 18" iron w/cap #24592 at intersection of N. & S. $\frac{1}{4}$
line with N. r/w line of M-60 N 00° 04' 37" W 296.68'; centerline of M-60 N 00° 04' 37" W
226.03'; $\frac{1}{2}$ " x 18" iron w/cap #24592 (magnetic North and not on $\frac{1}{4}$ line) 114.50'; S.W. cor.
Sec. 1, S 89° 48' 50" W 2667.68'; Center of Sec. 1, N 00° 04' 37" W 2656.55'.

And is accepted as a careful and faithful reestablishment of the position of the
original corner.

LIBER 1711 PAGE 082

Signed by Frederick J. Cutcher
Surveyor's Michigan License No. 24592

Date October 15, 1993