

1993

CALHOUN COUNTY REMONUMENTATION

RECORDED

COMMISSION

LAND CORNER RECORDATION CERTIFICATE  
Filing Requirement of Act 74, Mich. P.A. 1970

NOV 19 1 00 PM 93

For corners in

Calhoun County  
(County)

Located In:

Corner Code =#

1. Public Land Survey T 4 S R 6 W I-10  
T R  
T R  
T R
2. Property Controlling S T R  
in Section S T R
3. Miscellaneous S T R  
Property in Sec. S T R

CLERK-REGISTER  
CALHOUN COUNTY, MICH.  
ANNE B. HILL ALDER

Register of Deeds Stamp & File Number

4. Lot No. , Recorded Plat
5. Private Claims

I, Donald J. Davis, in a field survey on November 1, 19 93,  
do hereby certify that under requirements of P.A. 74, Michigan P.A. of 1970, the corner points mentioned  
in lines 1 and 2 above were in conformance with regulations and rules therefore as required in the  
current manual of survey instructions of the United States Department of the Interior, Bureau of Land  
Management or by a decree of a Court of Law and/or that the corner points mentioned in lines 3, 4 and 5  
above were in conformance with the rules of the Michigan Board of Land Surveyors or by a Decree of a  
Court of Law; established, re-established, monumented, re-monumented, recovered, found as  
expressed below:

**NOTE: Not more than 4 corners, all in the same town and range, may be recorded  
on this certificate.**

A. Description of original monument and accessories and/or subsequent restoration:

Tile set in resurvey by proration of Government distances.

7" Apple tree S 10° E 24 Links.

6" Yellow Oak N 04° W 92 Links.

Tile destroyed by fence construction.

Corner reset by J. Alden in 1968 and F. Cutcher in 1972.

B. Description of corner evidence found and/or method applied in restoring or reestablishing corner:

Found 3/4" pipe 3' long in rocks at old fence corner. Corner has been used for many  
surveys in this area.

Accepted the corner as local perpetuation of true position.

	A	B	C	D	E	F	G	H	I	J	K	L	M
2	6	5	4	3	2	1							
3													
4	7	8	9	10	11	12							
5													
6	18	17	16	15	14	13							
7													
8	19	20	21	22	23	24							
9													
10	30	29	28	27	26	25							
11													
12	31	32	33	34	35	36							
13													

LIBER 1716 PAGE 631

C. Description of monument for corner and accessories established to perpetuate locating the position of the corner:

Set Berntsen monument with rocks around.


NW corner house foundation S 40° E 99.50'

NW corner house foundation S 40° W 101.90'

Nail & tag 40" Elm N 85° E 11.85'

Nail & Tag RR tie post North 5.00'

5' South of fence to East.

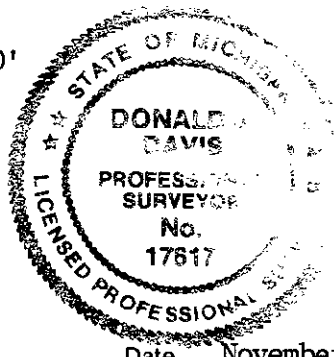

Signed by

*Donald J. Davis*

Date November 10, 1993

Surveyor's Michigan License No. 17617