

RECEIVED
MONUMENTATION
APR 06 1995
COMMISSION

STATE OF MICHIGAN
CASS COUNTY
RECEIVED FOR RECORD

LAND CORNER RECORDATION CERTIFICATE
Filing Requirement of Act 74, Mich. P.A. 1970

CASS COUNTY REMONUMENTATION 1994 DEC. 28 PM 1 47

CASS (County)

Located In: Corner Code ##

Public Land Survey

T 6 S R 16 W
T R
T R

Property Controlling

S 18 T 6 S R 16 W A-6

In Section

S T R South meander cor.

Miscellaneous

S T R

Property in Sec.

S T R

Ann. St. Diminova
CLERK/REGISTER

LIBER 2 PAGE 378

Register of Deeds Stamp & File Number

Ratified by Peer Group
In Accordance With P.A. 345
Chairman Dale L. Kuhn
Date Dec 22, 1994

Lot No. , Recorded Plat
Private Claims

Robert W. Prestine in a field survey on June 27, 1994
I hereby certify that under requirements of P.A. 74, Michigan P.A. of 1970, the corner points mentioned
lines 1 and 2 above were in conformance with regulations and rules therefore as required in the
current manual of survey instructions of the United States Department of the Interior, Bureau of Land
Management or by a decree of a Court of Law and/or that the corner points mentioned in lines 3, 4 and 5
above were in conformance with the rules of the Michigan Board of Land Surveyors or by a Decree of a
Court of Law; established, re-established, monumented, re-monumented, recovered, found as
restored below:

NOTE: Not more than 4 corners, all in the same town and range, may be recorded
on this certificate.

Description of original monument and accessories and/or subsequent restoration:

A-6 South meander corner on West side Section 18
Govt.
Set post Wm. Brookfield March 1828
35.83' North of SE corner Section 13, T. 6 S., R. 17 W
White Ash on corner
No other witness.

	A	B	C	D	E	F	G	H	I	J	K	L	M
2	6		5		4		3		2				
3													
4	7		8		9		10		11		12		
5													
6	18		17		16		15		14		13		
7													
8	19		20		21		22		23		24		
9													
10	30		29		28		27		26		25		
11													
12	31		32		33		34		35		36		
13													


SURVEY &
REMONUMENTATION
MAY 16 1997
COMMISSION

Description of corner evidence found and/or method applied in restoring or reestablishing corner:

Did not find corner. Set at prorated distance from SE corner of Section 13, T 6 S., R. 17 W
Govt. = 35.83 chains = 2364.78'. Set at 2365.10'. Total mile measures 5280.72'
in Section 13 on Section line. (County line)

Description of monument for corner and accessories established to perpetuate locating the position of the corner:

Set Berrien County remonumentation monument, also recorded in Berrien County Liber 3, page 120
Nail & Witness tag in East side 11" Maple S 20° W 3.53'
Nail & witness tag in South side 21" Whitewood N 87° E 41.12'
Nail & witness tag in South side 10" Maple S 77° W 18.45'
Nail & witness tag in South side 9" Ash N 64° W 24.49'
Waters edge North 18' ±

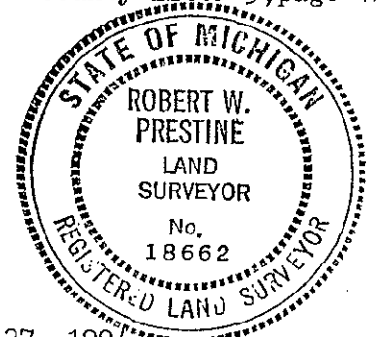

Surveyed by Robert W. Prestine

Date December 27, 1994

Surveyor's Michigan License No. 18662