

**CASS COUNTY REMONUMENTATION
LAND CORNER RECORDATION CERTIFICATE**
Filing Requirement of Act 74, Mich. P.A. 1970

For corners in **MILTON TOWNSHIP**

<u>CASS</u> (County)	Located In:	Corner Code #/
1. Public Land Survey	T <u>8S</u> R <u>16W</u>	<u>I-9</u>
	T _____ R _____	_____
	T _____ R _____	_____
	T _____ R _____	_____
2. Property Controlling in Section	S _____ T _____ R _____	_____
	S _____ T _____ R _____	_____
3. Miscellaneous Property in Sec.	S _____ T _____ R _____	_____
	S _____ T _____ R _____	_____

STATE OF MICHIGAN
COUNTY OF CASS
Recorded

12-22-1999 12:39:34

Ann L. Simmons
REGISTER OF DEEDS

Register of Deeds Stamp & File Number

Platified by Peer Group
In Accordance With P.A. 345
Chairman

4. Lot No. _____, Recorded Plat _____
5. Private Claims _____

I **CHRISTIAN F. MARBACH** in a field survey on **DECEMBER 7**, 19 **99**, do hereby certify that under requirements of P.A. 74, Michigan P.A. of 1970, the corner points mentioned in lines 1 and 2 above were in conformance with regulations and rules therefore as required in the current manual of survey instructions of the United States Department of the Interior, Bureau of Land Management or by a decree of a Court of Law and/or that the corner points mentioned in lines 3, 4 and 5 above were in conformance with the rules of the Michigan Board of Land Surveyors or by a Decree of a Court of Law; established, re-established, monumented, re-monumented, recovered, found as expressed below:

NOTE: Not more than 4 corners, all in the same town and range, may be recorded on this certificate.

A. Description of original monument and accessories and/or subsequent restoration:

**ORIGINAL MONUMENT: SET POST CORNER TO FRACTIONAL SEC. 22 & 23 8.98 CHAINS E. OF
34th MILE POST (BROOKFIELD, 1828)**

**ACCESSORIES: 30" WHITE OAK N 70° EAST 1.22 LINKS
22" HICKORY N 47° WEST 1.91 LINKS**


**SUBSEQUENT RESTORATION: FOUND STONE (PRESTINE 1973)
CL 18" CHERRY N 7° WEST 17.0'
CL 18" APPLE N 80° WEST 17.6'
OLD FENCE & BRUSH ROW GOING SOUTH INTO INDIANA 51.0'**

B. Description of corner evidence found and/or method applied in restoring or reestablishing corner:

FOUND STONE BASED ON ABOVE REFERENCES

RF
FEB 4 2000

SECTION

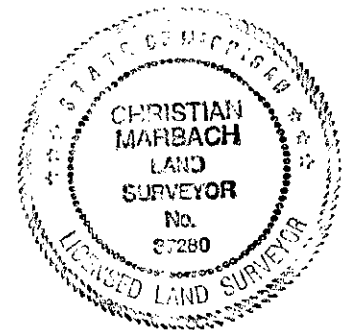

C. Description of monument for corner and accessories established to perpetuate locating the position of the corner:

CONCRETE MONUMENT (36" LONG/REBAR WITH ALUM. TABLET) SET OVER FOUND STONE TABLET IS STAMPED "CASS COUNTY REMONUMENTATION" AND IS ACCEPTED AS A CAREFUL AND FAITHFUL PERPETUATION OF THE POSITION OF THE ORIGINAL CORNER.

**PK IN NORTH SIDE 8" APPLE N 80° W 17.6'
PK IN EAST SIDE 30 " CHERRY N 7° WEST 17.0'
PK IN NORTH SIDE 10" OAK N 45° EAST 20.38'
PK IN NORTH SIDE 8" OAK N 90° EAST 11.2'**

Signed by Chris L. Marbach
Surveyor's Michigan License No. 37280

Date 12/21/99