

LAND CORNER RECORDATION CERTIFICATE

FILING REQUIREMENT OF ACT 74, MICH. P.A. 1970
Chippewa Co. 2 Corners.

FOR CORNERS OF--	LOCATED IN--	CORNER CODE NUMBER
1. PUBLIC LAND SURVEY	T. <u>42</u> N. <u>2</u> E.	K-5, M-9
2. PROPERTY CONTROLLING IN SECTION	T. _____ S. _____ R. _____ E. _____ W. _____	
3. MISCELLANEOUS PROPERTY IN SECTION	T. _____ S. _____ R. _____ E. _____ W. _____	
4. LOT NO. _____, RECORDED PLAT _____		
5. PRIVATE CLAIMS _____		

REGISTER OF DEEDS STAMP AND
FILING NUMBER

I, Billy D. Buckler, do hereby certify that under requirements of P.A. 74, Michigan P.A. of 1970, the corner points mentioned in lines 1 and 2 above were, in a field survey on 8-13, 1979, established, re-established, monumented, re-monumented, recovered or restored as expressed below and in conformance with regulations and rules therefore as required in the current manual of survey instructions of the United States Department of the Interior, Bureau of Land Management or by a decree of a court of law. Furthermore, that the corner points mentioned in lines 3, 4 and 5 above were, in a field survey on _____, 19____, found, recovered, restored, established or re-established as expressed below and in conformance with the rules of the Michigan State Board of Registration for Land Surveyors or, by a Decree of a Court of law:

A. Description of original monument and accessories and/or subsequent restoration:

K-5 Sec. Corner 11-12-13-14, set by John Mullett, D.S. in 1845. Bearings were: Cedar 8", S43°E, 10 lks. & Hemlock 10", N58°W, 24 lks.

M-9 Section Corner 24-25, on East Boundary of Township set by Wm Burt, D.S. in 1840. Bearings were: Sugar 10", N68°W, 22 lks. & Beech 26", S13°W, 23 lks.

B. Description of corner evidence found and/or method applied in restoring or re-establishing corner:

K-5 Placed corner in intersection of roads, East, West, and South. Found no evidence of original corner. Checks well with other corners in area.


M-9 Placed corner by Single Proportionate Measure along Township line. Found no evidence of original corner.

C. Description of monument for corner and accessories established to perpetuate locating the position of the corner:

K-5 Buried 1" pipe with 4" aluminium cap at corner.
New Bearings: 8" W. Birch, S58°E, 51.8' & 14" R. Maple, N60°E, 56.0'.

M-9 Placed 1" pipe with 4" aluminium cap at corner.
New Bearings: 10" Beech, S60°E, 6.5' & 10" Beech, S65°W, 31.15' & 12" Beech, N44°E, 50.3'. Corner lies 21' South of Road.

SIGNED BY Billy D. Buckler DATE 9-21-79
Billy D. Buckler
SURVEYOR'S MICHIGAN REGISTRATION NO. 8887

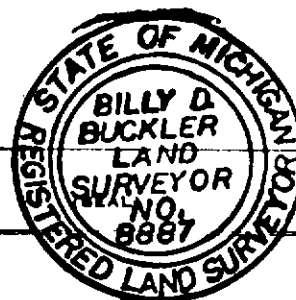

FOR STATE AND UNITED STATES AGENCIES:

SIGNED BY _____ DATE _____
CHIEF OF SURVEY PARTY
APPROVED AND SIGNED BY _____ DATE _____
MICHIGAN REGISTERED LAND SURVEYOR

(SEAL)

SURVEYOR'S MICHIGAN REGISTRATION NO. _____