

NOV 07 1994

LAND CORNER RECORDATION CERTIFICATE  
Filing Requirement of Act 74, Mich. P.A. 1970

For corners in COMMISSION

Chippewa (County) Located In: Corner Code ##


1. Public Land Survey T 44N R 1W E-13

2. Property Controlling in Section S T

3. Miscellaneous Property in Sec. S T

4. Lot No. , Recorded Plat

5. Private Claims

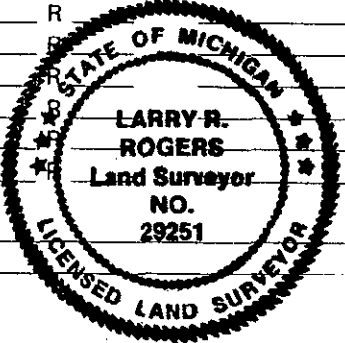

\$ 7.00 LAND CORNER  
\$ 2.00 MSSR  
26 OCT 94 9:42 A.M. RECEIPT# 860  
RECEIVED FOR RECORD  
CHIPPewa COUNTY - STATE OF MICHIGAN  
SHARON H. KENNEDY, REGISTER OF DEEDS

Register of Deeds Stamp & File Number

I, Larry R. Rogers, in a field survey on November 8, 19 93, do hereby certify that under requirements of P.A. 74, Michigan P.A. of 1970, the corner points mentioned in lines 1 and 2 above were in conformance with regulations and rules therefore as required in the current manual of survey instructions of the United States Department of the Interior, Bureau of Land Management or by a decree of a Court of Law and/or that the corner points mentioned in lines 3, 4 and 5 above were in conformance with the rules of the Michigan Board of Land Surveyors or by a Decree of a Court of Law; established, re-established, monumented, re-monumented, recovered, found as expressed below:

NOTE: Not more than 4 corners, all in the same town and range, may be recorded on this certificate.


A. Description of original monument and accessories and/or subsequent restoration:  
(E-13) Standard Corner Between Sections 32 & 33, T44N-R1W

1874 William L. Karr, P.S. #27450, found 1 3/4" O.D. pipe in centerline of East-West paved road. Accepted corner location as found. Recorded in Liber 6, Page 125 of Chippewa County Corner Records.

Ties: Corner Fence Post S40°E 68.69'  
Corner Fence Post S20°W 50.75'  
Fence Post N27°W 59.63'  
Closing Corner East 13.18' (13.2' GLO)

B. Description of corner evidence found and/or method applied in restoring or reestablishing corner:  
(E-13) This corner is being perpetuated as part of the Chippewa County Remonumentation Program.

Found 1 3/4" pipe in centerline of Townline Road. Found all ties listed above. Found a 1' discrepancy to the Corner Fence Post S20W 50.75'. Accepted corner position as found and rewitnessed.

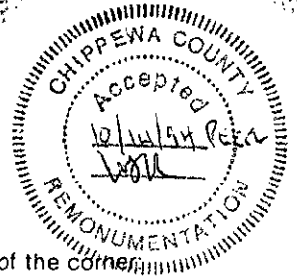

C. Description of monument for corner and accessories established to perpetuate locating the position of the corner:  
(E-13) Corner is a 1 3/4" pipe with plastic "Chippewa County Remonumentation Corner" cap. Corner falls in the centerline of Townline Road (East-West, paved) and 15' West of the centerline of a dirt road to the South.

Witnesses:

End Fence Post S40°E 68.77' (existing, added nail & tag)  
Corner Fence Post S18°W 51.75' (existing, added nail & tag)  
Corner Fence Post N26°W 59.59' (existing, added nail & tag)  
"V" Notch in End of CMP N20°W 24.60'  
Closing Corner Sections 4/5 S82°E 13.38'

Signed by [Signature] Date 24 OCT 1994  
Surveyor's Michigan License No. 29251

NOTE: Bearings are compass bearings corrected for declination.  
Distances are to a nail in side of witness objects unless noted.