

NOV 07 1994

LAND CORNER RECORDATION CERTIFICATE
Filing Requirement of Act 74, Mich. P.A. 1970

For corners in COMMISSION

Chippewa
(County)

Located In:

Corner Code ##

1. Public Land Survey

T 44N R 1W K-13

2. Property Controlling
in Section


S T

3. Miscellaneous
Property in Sec.

S T

4. Lot No. , Recorded Plat

5. Private Claims

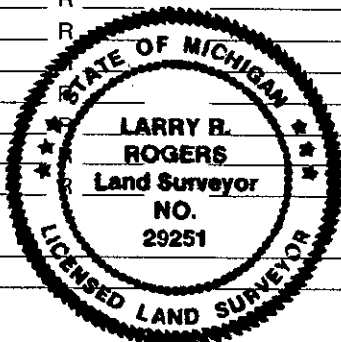

\$ 7.00 LAND CORNER

\$ 2.00 MSSR

26 OCT 94 9:45 A.M. RECEIPT# 860

RECEIVED FOR RECORD

CHIPPEWA COUNTY - STATE OF MICHIGAN
SHARON H. KENNEDY, REGISTER OF DEEDS

Register of Deeds Stamp & File Number

I, Larry R. Rogers, in a field survey on May 10, 19 94

do hereby certify that under requirements of P.A. 74, Michigan P.A. of 1970, the corner points mentioned in lines 1 and 2 above were in conformance with regulations and rules therefore as required in the current manual of survey instructions of the United States Department of the Interior, Bureau of Land Management or by a decree of a Court of Law and/or that the corner points mentioned in lines 3, 4 and 5 above were in conformance with the rules of the Michigan Board of Land Surveyors or by a Decree of a Court of Law; established, re-established, monumented, re-monumented, recovered, found as expressed below:

NOTE: Not more than 4 corners, all in the same town and range, may be recorded on this certificate.

A. Description of original monument and accessories and/or subsequent restoration:

(K-13) Standard Corner Between Sections 35 & 36, T44N-R1W

1986 William L. Karr, P.S. #27450 found 1 1/4" pipe at road intersection. Accepted location as found after Section retracement survey.

Witnesses:

1/2" x 18" iron with cap #27450

at fence corner

S49°E 53.11'

1/2" x 18" iron with cap #27450

at fence corner

S27°W 32.84'

Utility Pole

N58°W 57.27'


4 x 4 wood sign post

N41°E 44.41'

B. Description of corner evidence found and/or method applied in restoring or reestablishing corner.

(K-13) This corner is being perpetuated as part of the Chippewa County Remonumentation Program.

Found 1 1/4" pipe with PK nail in center as recorded by Karr. Found utility pole witness listed above. Found PK nail (Closing Corner Sections 1 & 2) 19.5 feet East of pipe (GLO = 15.18). Accepted corner position as found and set 10" long remonumentation iron in center of pipe.

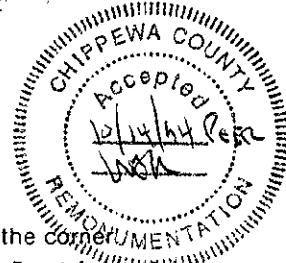

C. Description of monument for corner and accessories established to perpetuate locating the position of the corner

(K-13) Corner is a 1 1/4" pipe with a 3/4" x 10" iron in the center with a plastic "Chippewa County Remonumentation Corner" cap. Corner falls 2' North of the centerline of Townline Road (East-West, paved) and on centerline of Steele Road to the North.

Witnesses: Corner Fence Post

N51°E 46.84'

Top Center Telephone Box

S32°E 55.52'

Corner Fence Post

S52°W 33.89'

Power Pole

N61°W 57.24' (existing, added nail & tag)

Closing Corner PK

East 15.50'

Signed by [Signature]

Date 24 OCT 1994

Surveyor's Michigan License No. 29251

NOTE: Bearings are compass bearings corrected for declination.
Distances are to a nail in side of witness objects unless noted.