

SURVEY &  
REMONUMENTATION

APR 26 1995

CHIPPEWA COUNTY REMONUMENTATION CORNER

COMMISSION

LAND CORNER RECORDATION CERTIFICATE

Filing Requirement of Act 74, Mich. P.A. 1970

For corners in  
Chippewa

(County)

Located In:

Corner Code #

1. Public Land Survey

T44N R2W

E-2

2. Property Controlling  
in Section

S T R

3. Miscellaneous

S T R

Property in Sec.

S T R

4. Lot No. , Recorded Plat

5. Private Claims

\$ 7.00 LAND CORNER

\$ 2.00 MSSR

24 OCT 94 3:46 P.M. RECEIPT# 831

RECEIVED FOR RECORD

CHIPPEWA COUNTY - STATE OF MICHIGAN

SHARON H. KENNEDY, REGISTER OF DEEDS

Register of Deeds Stamp & File Number

I, Keith R. Waters, in a field survey on June 8, 1994

do hereby certify that under requirements of P.A. 74, Michigan P.A. of 1970, the corner points mentioned in lines 1 and 2 above were in conformance with regulations and rules therefore as required in the current manual of survey instructions of the United States Department of the Interior, Bureau of Land Management or by a decree of a Court of Law and/or that the corner points mentioned in lines 3, 4 and 5 above were in conformance with the rules of the Michigan Board of Land Surveyors or by a Decree of a Court of Law; established, re-established, monumented, re-monumented, recovered, found as expressed below:

**NOTE:** Not more than 4 corners, all in the same town and range, may be recorded on this certificate.

A. Description of original monument and accessories and/or subsequent restoration:

E-2 1/4 Corner Common to Sections 4 & 5, T44N, R2W

Original notes indicate a 10" Fir for corner.

Found no evidence of subsequent restoration of corner.

B. Description of corner evidence found and/or method applied in restoring or reestablishing corner:

E-2 (T44N, R2W)

This corner is being re-established as part of the Chippewa County Remonumentation Program.

Found no evidence of corner. Re-established corner on line between Section corner 2641.44 feet to the south and closing section corner 2694.94 feet to the north, on the extension of an old fence line to the west. Corner falls in the approximate centerline of a north-south dirt road (Centerline Road) and is at the approximate split of north-south right-of-way fences 50 feet apart on both sides of the road. North-south position works well with a fence on the south 1/16 line of Section 4.


C. Description of monument for corner and accessories established to perpetuate locating the position of the corner:

E-2 (T44N, R2W)

Corner is a 3/4" x 24" rebar with a plastic Chippewa County Remonumentation cap in the centerline of north-south dirt road. Witnesses:

5" Apple, S69°E 30.11'  
Power Pole, S82°W 28.72'  
1/2" Iron w/cap 33142, EAST 33.00'  
Power Pole (88), N05°W 303.00'

Note: Distances to apple and poles are to a nail and tag in the side. Apple is blazed and painted. Bearings are compass bearings corrected for declination.

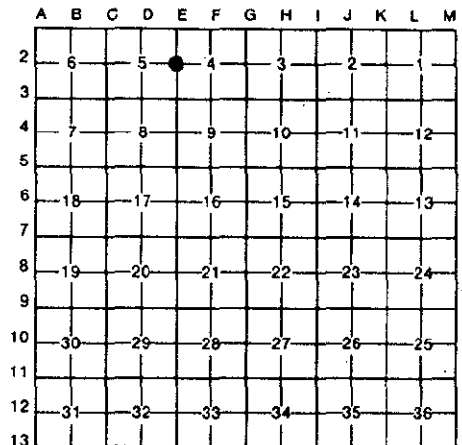

Signed by Keith R. Waters

Date 10-18-94

Surveyor's Michigan License No. 33142

FORM APPROVED BY MICHIGAN STATE BOARD OF LAND SURVEYORS, JAN. 18, 1971  
REVISED MAY 14, 1975  
REVISED JAN. 1983

