

SURVEY & REMONUMENTATION

APR 07 1998

Chippewa County Remonumentation Corner LAND CORNER RECORDATION CERTIFICATE Filing Requirement of Act 74, Mich. P.A. 1970

SECTION

For corners in

Chippewa Located In: Corner Code #

1. Public Land Survey T 45N R 1E B-3
T R
T R
T R

2. Property Controlling S T R
in Section S T R
3. Miscellaneous S T R
Property in Sec. S T R

\$7.00 LAND CORNER
\$2.00 MSSR
14 Jan 1998 3:15:07 PM Receipt #5566
RECEIVED FOR RECORD
CHIPPewa COUNTY - STATE OF MICHIGAN
SHARON H. KENNEDY, REGISTER OF DEEDS

BOOK 10 PAGE 109

Register of Deeds Stamp & File Number

4. Lot No. , Recorded Plat
5. Private Claims

I, Larry R. Rogers, in a field survey on October 22, 1997, do hereby state that under requirements of P.A. 74, Michigan P.A. of 1970, the corner points mentioned in lines 1 and 2 above were in conformance with regulations and rules therefore as required in the current manual of survey instructions of the United States Department of the Interior, Bureau of Land Management or by a Decree of a Court of Law and/or that the corner points mentioned in lines 3, 4 and 5 above were in conformance with the rules of the Michigan Board of Land Surveyors or by a Decree of a Court of Law; established, re-established, monumented, recovered, found as expressed below:

NOTE: Not more than 2 corners, all in the same town and range, may be recorded on this certificate.

A. Description of original monument and accessories and/or subsequent restoration:

(B-3) 1/4 Corner Common to Sections 6 and 7, T.45 N., R.1 E.

Original corner post was placed in September, 1845 by James H. Mullett with the following witnesses:
10" Birch S78°E 17 links 16" Birch N68°W 25 links

Notes in County Surveyor office indicate corner was restored by County Surveyor, Stillwell from original B.T. 1904 notes indicate a fence on the North-South 1/4 line.

B. Description of corner evidence found and/or method applied in restoring or reestablishing corner:

(B-3) 1/4 Corner Common to Sections 6 and 7, T.45 N., R.1 E.

This corner is being re-established as part of the Chippewa County Remonumentation Program.



Found no evidence or original corner position Found 1/2" iron pin in centerline of Thirteen Mile Road on extension of fence to South. Corner matches County Surveyor distance to East and is 7' short of County Surveyor distance to West. Accepted corner position as found and established four new witnesses.

C. Description of monument for corner and accessories established to perpetuate locating the position of the corner:

(B-3) 1/4 Corner Common to Sections 6 and 7, T.45 N., R.1 E.

Corner is a 1/2" iron pin in the centerline of Thirteen Mile Road and on the extension of a fence to the South.

Witnesses: 4" Red Pine N10°E 75.79'
6" White Spruce S68°E 133.59'
18" Oak S48°W 46.47'
10" White Spruce S78°W 118.36'

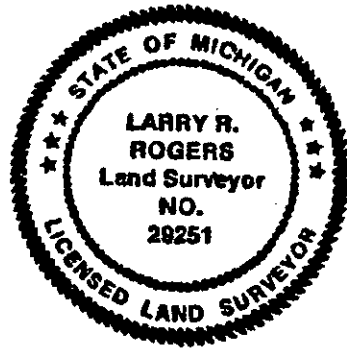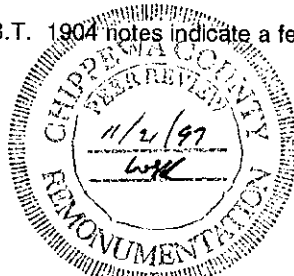

Signed by [Signature] Date 19 DEC 1997

Surveyor's Michigan License No. 29251

NOTE: All bearings are compass bearings. All distances are to a nail in side of witness objects unless noted.