SURVEY & REMONUMENTATION

APR 0 7 1998

SECTION

For corners in

5. Private Claims


Chippewa County Remonumentation Corner LAND CORNER RECORDATION CERTIFICATE Filing Requirement of Act 74, Mich. P.A. 1970

Chippewa	Located In:	Corner Code #
1. Public Land Survey	T <u>45N</u> R <u>1E</u> T R T R T B	<u>G-5</u> —
Property Controlling in Section Miscellaneous	S T R S T R S T R	 - -
Property in Sec. 4. Lot No. Reco	S T R	


47.00 LAND CORNER \$2.00 NSSR 14 Jan 1998 3:40:19 PM Receipt #5566 RECEIVED FOR RECORD CHIPPENA COUNTY - STATE OF MICHIGAN SHARGN H. KENNEDY, REGISTER OF DEEDS

BOOK 10 PAGE 128

Register of Deeds Stamp & File Number

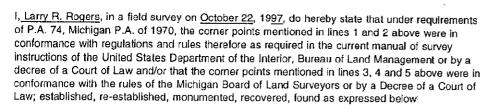

Not more than 2 corners, all in the same town and range, may be recorded on this certificate.

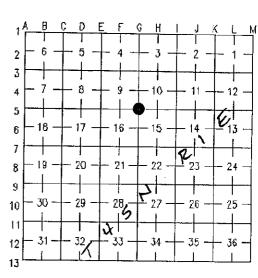

A. Description of original monument and accessories and/or subsequent restoration:

(G-5) Corner Common to Sections 9, 10, 15 and 16, T.45 N., R.1 E.

Original corner post was placed in September, 1845 by James H. Mullett. 1900 County Surveyor notes show no evidence found of original corner position. 1996 recorded survey by Ronald Bischer, P.S. 22428, indicate he set a 1/2" iron pin at a found squared cedar post.

B. Description of corner evidence found and/or method applied in restoring or reestablishing corner:

(G-5) Corner Common to Sections 9, 10, 15 and 16, T45 N., R.1 E.

This corner is being re-established as part of the Chippewa County Remonumentation Program.

Found 1/2" iron pin and three Bischer witnesses. Corner is 1' East of squared cedar post, 2' North of fence to West and 9' East of fence to South. Bischer notes indicate a North-South fence 14' East of corner but fence has apparently been removed. Accepted corner position as found and established one new witness.

C. Description of monument for corner and accessories established to perpetuate locating the position of the corner:

3.45

(G-5) Corner Common to Sections 9, 10, 15 and 16, T.45 N., R.1 E.

Corner is a 1/2" iron pin 1' East of squared cedar post.

Witnesses:

10" Aspen 10" White Spruce

N59°W 25.26 Corner fence post S81°W 8.87 4" White Birch S00'W 20.09 Steel fence post North 20'

N45°E

MICHIG ARRY R. ROGERS and Surveyor NO. 29251 LAND

Signed by 29251 Surveyor's Michigan License No.

Date 19 Dec 1997

NOTE: All bearings are compass bearings. All distances are to a nail in side of witness objects unless noted.

FORM APPROVED BY MICHIGAN STATE BOARD OF PROFESSIONAL SURVEYORS, JAN. 28, 1971