

MAR 09 1994

CHIPPEWA COUNTY REMONUMENTATION CORNER

LAND CORNER RECORDATION CERTIFICATE

Filing Requirement of Act 74, Mich. P.A. 1970

For corners in CHIPPEWA  
(County)

Located in: Corner Code #


RECEIVED FOR RECORD  
CHIPPEWA COUNTY  
STATE OF MICHIGAN

93 DEC 30 PM 2:46

*J. Ryan Mallick*  
REGISTER OF DEEDS

Register of Deeds Stamp & File Number

1. Public Land Survey T 45N R 1E G-7  
T \_\_\_\_\_ R \_\_\_\_\_  
T \_\_\_\_\_ R \_\_\_\_\_  
T \_\_\_\_\_ R \_\_\_\_\_
2. Property Controlling S \_\_\_\_\_ T \_\_\_\_\_ R \_\_\_\_\_  
in Section S \_\_\_\_\_ T \_\_\_\_\_ R \_\_\_\_\_
3. Miscellaneous S \_\_\_\_\_ T \_\_\_\_\_ R \_\_\_\_\_  
Property in Sec. S \_\_\_\_\_ T \_\_\_\_\_ R \_\_\_\_\_
4. Lot No. \_\_\_\_\_, Recorded Plat \_\_\_\_\_
5. Private Claims \_\_\_\_\_

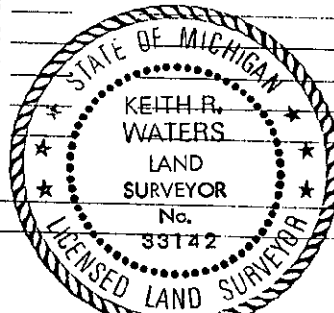

	A	B	C	D	E	F	G	H	I	J	K	L	M
2	6		5		4		3		2		1		
3													
4	7		8		9		10		11		12		
5													
6	18		17		16		15		14		13		
7													
8	19		20		21		22		23		24		
9													
10	30		29		28		27		26		25		
11													
12	31		32		33		34		35		36		
13													

I, Keith R. Waters in a field survey on November 24, 19 93  
do hereby certify that under requirements of P.A. 74, Michigan P.A. of 1970, the corner points mentioned  
in lines 1 and 2 above were in conformance with regulations and rules therefore as required in the  
current manual of survey instructions of the United States Department of the Interior, Bureau of Land  
Management or by a decree of a Court of Law and/or that the corner points mentioned in lines 3, 4 and 5  
above were in conformance with the rules of the Michigan Board of Land Surveyors or by a Decree of a  
Court of Law; established, re-established, monumented, re-monumented, recovered, found as  
expressed below:

NOTE: Not more than 4 corners, all in the same town and range, may be recorded  
on this certificate.

A. Description of original monument and accessories and/or subsequent restoration:

G-7 Corner Common to Sections 15, 16, 21, & 22, T45N, R1W

Original ties to post: Birch 10, N56°E 38 links White Pine 20, S29°W 30 links

This corner is recorded in liber 6, page 16, of Chippewa County corner records  
by James L. Fletcher, P.S. 19830 (1982), as a set 1/2" rerod with cap. Corner  
position was established using two witnesses from County Surveyor records.

Witnesses: Anchor Pole, N54°W 48.76' Anchor Pole, S30°W 61.78'  
4" Spruce, S24°E 62.58' Center of Road, SOUTH 3.9'

B. Description of corner evidence found and/or method applied in restoring or reestablishing corner:

G-7 (T45N, R1E)

This corner is being perpetuated as part of the Chippewa County  
Remonumentation Program.

Found a 1/2" iron pin in a monument box 3.6 feet north of centerline of east-  
west asphalt road (15 Mile Road) at intersection of north-south gravel road  
(Ridge Road). 15 Mile Road has been repaved since previous recording.  
Found two cut off power poles, which appear to be the same ones used as  
witnesses in previous recording. Distance to PK nails in sides of poles  
differ by 0.11 feet and 0.53 feet, but I don't think that they are what  
Fletcher used. Position works well with found 1/4 corner and section corner  
to the east. Accepted corner as found and set a plastic cap #33142 on iron.

Description of monument for corner and accessories established to perpetuate locating the position of the corner:

G-7 (T45N, R1E)

Corner is a 1/2" iron pin with cap #33142 in a monument box 3.6 feet north of  
centerline of 15 Mile Road at intersection of Ridge Road. Witnesses:

PK in cut off pole (15B3), N55°W 48.65'  
PK in cut off pole, S33°W 61.25'  
PK in power pole (DR2-176), S11°E 90.88'  
Nail and tag in 12" maple, N73°E 101.15'

Note: Maple is blazed and painted.  
Bearings are compass bearings  
corrected for declination.

igned by Keith R. Waters

Date 12-30-93

urveyor's Michigan License No. 33142