

**SURVEY &
REMONUMENTATION**

CHIPPEWA COUNTY REMONUMENTATION CORNER

APR 26 1995

COMMISSION

LAND CORNER RECORDATION CERTIFICATE

Filing Requirement of Act 74, Mich. P.A. 1970

For corners in
Chippewa

(County)

Located In:

Corner Code ##

1. Public Land Survey


2. Property Controlling
in Section

3. Miscellaneous
Property in Sec.

4. Lot No. _____, Recorded Plat _____

5. Private Claims _____

T 45N R 1W C-10
T _____ R _____
T _____ R _____
T _____ R _____
S _____ T _____ R _____
S _____ T _____ R _____
S _____ T _____ R _____
S _____ T _____ R _____

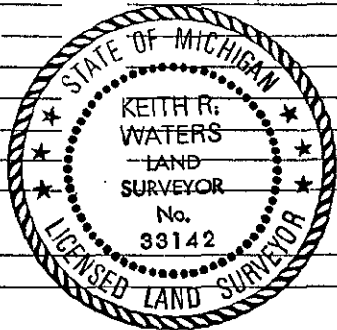

\$ 7.00 LAND CORNER

\$ 2.00 NSSR

19 JAN 95 4:11 P.M. RECEIPT# 2266

RECEIVED FOR RECORD

CHIPPEWA COUNTY - STATE OF MICHIGAN
SHARON H. KENNEDY, REGISTER OF DEEDS

Register of Deeds Stamp & File Number

Keith R. Waters

November 23 1994

I, _____, in a field survey on _____, 19____, do hereby certify that under requirements of P.A. 74, Michigan P.A. of 1970, the corner points mentioned in lines 1 and 2 above were in conformance with regulations and rules therefore as required in the current manual of survey instructions of the United States Department of the Interior, Bureau of Land Management or by a decree of a Court of Law and/or that the corner points mentioned in lines 3, 4 and 5 above were in conformance with the rules of the Michigan Board of Land Surveyors or by a Decree of a Court of Law; established, re-established, monumented, re-monumented, recovered, found as expressed below:

NOTE: Not more than 4 corners, all in the same town and range, may be recorded on this certificate.

A. Description of original monument and accessories and/or subsequent restoration:

C-10 1/4 Corner Common to Sections 29 & 30, T45N, R1W.

Original ties to post: Fir 10, N46°E 06 links Fir 12, S88°W 20 links
1978 - As recorded in liber 1, page 363, Chippewa County corner records, by Thomas Kelly, RLS 24599. Set 1/2" iron. Witnesses: PK nail, WEST 10.00' PK nail, N50°E 26.39' Power Pole, S20°W 52.05'
1980 & 1981 - Corner shown in Kinross Township Commercial Plats Nos. 1 & 2.

B. Description of corner evidence found and/or method applied in restoring or reestablishing corner:

C-10 (T45N, R1W)

This corner is being perpetuated as part of the Chippewa County Remonumentation Program.

Found a 1/2" iron with plastic cap #24599 in the approximate centerline of a north-south asphalt road. Also found three witness objects as shown in liber 1, page 363. Corner was established by Thomas Kelly by single proportionate measurement between section corners 2638.86 feet north and south. Corner has been used in numerous surveys in the area. Accepted corner as found and established new witness objects.

C. Description of monument for corner and accessories established to perpetuate locating the position of the corner:

C-10 (T45N, R1W)

Corner is a 1/2" iron with plastic cap #24599 in the approximate centerline of a north-south asphalt road. Witnesses:

PK Nail, WEST 10.00'

PK Nail, N48°E 26.34'


Power Pole (D27), S18°W 52.10'

Power Pole (D28), N09°W 102.58'

Center of Top Center Bolt on

Hydrant, S80°E 159.78'

Note: Distances to power poles are to a nail and tag in the side. Bearings are compass bearings corrected for declination

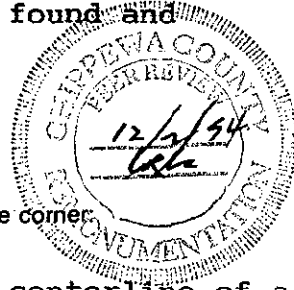

Signed by Keith R. Waters

Date 12-23-94

Surveyor's Michigan License No. 33142