

SURVEY &
REMONUMENTATIONCHIPPEWA COUNTY REMONUMENTATION CORNER

APR 26 1995

LAND CORNER RECORDATION CERTIFICATE
Filing Requirement of Act 74, Mich. P.A. 1970

For corners in
Chippewa

(County)

Located In:

Corner Code #

1. Public Land Survey

T 45N R 2W E-13

2. Property Controlling
in Section

S

S


3. Miscellaneous
Property in Sec.

S

S

4. Lot No. , Recorded Plat

5. Private Claims

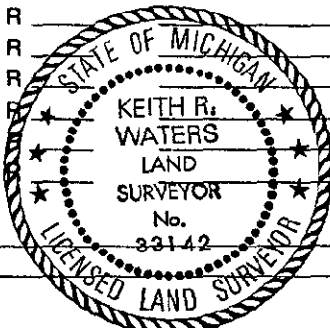

\$ 7.00 LAND CORNER

\$ 2.00 HSSR

19 JAN 95 4:21 P.M. RECEIPT# 2266

RECEIVED FOR RECORD

CHIPPEWA COUNTY - STATE OF MICHIGAN
SHARON H. KENNEDY, REGISTER OF DEEDS

Register of Deeds Stamp & File Number

	A	B	C	D	E	F	G	H	I	J	K	L	M
2	6	5	4	3	2	1							
3													
4	7	8	9	10	11	12							
5													
6	18	17	16	15	14	13							
7													
8	19	20	21	22	23	24							
9													
10	30	29	28	27	26	25							
11													
12	31	32	33	34	35	36							
13													

Keith R. Waters

December 5

94

I, in a field survey on do hereby certify that under requirements of P.A. 74, Michigan P.A. of 1970, the corner points mentioned in lines 1 and 2 above were in conformance with regulations and rules therefore as required in the current manual of survey instructions of the United States Department of the Interior, Bureau of Land Management or by a decree of a Court of Law and/or that the corner points mentioned in lines 3, 4 and 5 above were in conformance with the rules of the Michigan Board of Land Surveyors or by a Decree of a Court of Law; established, re-established, monumented, re-monumented, recovered, found as expressed below:

NOTE: Not more than 4 corners, all in the same town and range, may be recorded on this certificate.

A. Description of original monument and accessories and/or subsequent restoration:

E-13 Corner Common to Sections 32 & 33, on South Boundary of T45N, R2W.
(Standard Corner on Township Line).

Original ties to post: Fir 12, N12°E 26 links Black Ash 10, N04°W 23 links.
1959 - Corner recorded in liber 3, page 225, Chippewa County corner records
(Highway Department). Found 1" iron pin. Witnesses: T. Pole, S40°E
43.77', T. Pole, S55°W 47.00'. Corner is called out as being the NW
corner of Section 4, T44N, R2W, or the closing corner. It does not
appear that double corners were recognized at this position.

B. Description of corner evidence found and/or method applied in restoring or reestablishing corner:

E-13 (T45N, R2W)

This corner is being re-established as part of the Chippewa County
Remonumentation Program.

Found a 1" iron pin 1 foot below surface of north-south gravel road as called
for in liber 3, page 225. It appears that this corner is actually the closing
corner common to Sections 4 & 5, T44N, R2W, and I am accepting it as such.
Re-established standard corner on township line at record GLO distance west
(19 links or 12.54') of closing corner. Corner is on the extension of the
centerline of gravel road to the north, on the south side of railroad tracks.

C. Description of monument for corner and accessories established to perpetuate locating the position of the corner:

E-13 (T45N, R2W)

Corner is a 3/4" x 24" rebar with a plastic Chippewa County Remonumentation
cap at the intersection of gravel roads north, south, east, and west, on the
south side of railroad tracks. Witnesses:

Power Pole, S30°W 87.33'

Power Pole (97), N38°W 85.11'

Telephone Pole, S56°E 67.33'

PK Nail w/tag in RR tie,

N41°E 19.87'

Closing Corner, EAST 12.54'

Note: Distances to pole are to a nail and
tag in the side. Bearings are compass
bearings corrected for declination.

Signed by Keith R. Waters

Date 12-23-94

Surveyor's Michigan License No. 33142