

MAR 09 1994

Chippewa County Remonumentation Corner

RECEIVED FOR RECORD
CHIPPEWA COUNTY
STATE OF MICHIGAN

COMMISSION

LAND CORNER RECORDATION CERTIFICATE
Filing Requirement of Act 74, Mich. P.A. 1970

93 DEC 14 PM 4: 26

For corners in

Chippewa

(County)

Located In:

Corner Code #

1. Public Land Survey

T 46N R 1E

D-3

2. Property Controlling
in Section

S T R

3. Miscellaneous

S T R

Property in Sec.

S T R

4. Lot No. , Recorded Plat

5. Private Claims

J. Roger Malott

REGISTER OF DEEDS

Register of Deeds Stamp & File Number

I, William L. Karr, in a field survey on November 24, 19 93

do hereby certify that under requirements of P.A. 74, Michigan P.A. of 1970, the corner points mentioned in lines 1 and 2 above were in conformance with regulations and rules therefore as required in the current manual of survey instructions of the United States Department of the Interior, Bureau of Land Management or by a decree of a Court of Law and/or that the corner points mentioned in lines 3, 4 and 5 above were in conformance with the rules of the Michigan Board of Land Surveyors or by a Decree of a Court of Law; established, re-established, monumented, re-monumented, recovered, found as expressed below:

NOTE: Not more than 4 corners, all in the same town and range, may be recorded on this certificate.

A. Description of original monument and accessories and/or subsequent restoration:

(D-3) 1/4 Corner common to Sections 5 & 8, (T46N-R1E)

This corner was recorded by L.R. Rogers, L.S. 29251 in Liber 7, Page 398 of the Chippewa County Corner Records as a 1/2" iron with cap #29251 with the following witnesses:

Wood Corner Fence Post	N04°E	48.82'
Power Pole	N50°E	43.72'
"V" Notch in C.M.P.	S40°W	21.73'
4" Aspen	N20°W	85.71'

B. Description of corner evidence found and/or method applied in restoring or reestablishing corner:

(D-3) This corner is being perpetuated as part of the Chippewa County Remonumentation Program.



Found 1/2" iron with cap #29251 and three witnesses as called for. Accepted corner position as found and added two new witnesses.

	A	B	C	D	E	F	G	H	I	J	K	L	M
2	6			5		4		3		2		1	
3													
4	7			8		9		10		11		12	
5													
6	13			14		15		16		17		18	
7													
8	19			20		21		22		23		24	
9													
10	25			26		27		28		29		30	
11													
12	31			32		33		34		35		36	
13													

C. Description of monument for corner and accessories established to perpetuate locating the position of the corner:

(D-3) Corner is a 1/2" iron with cap #29251 and falls approximately 2' South of the centerline of Seven Mile Road (gravel) on the extension of a fence line to the North. Corner falls approximately 4.5' East of extension of fence line to the South.

Witnesses: Wood Corner Fence Post	N04°E	48.82'
Power Pole	N50°E	43.72'
"V" Notch in C.M.P.	S40°W	21.73'
"V" Notch in C.M.P.	N09°W	22.00'
1/2" iron with cap #33142	South	32.88'

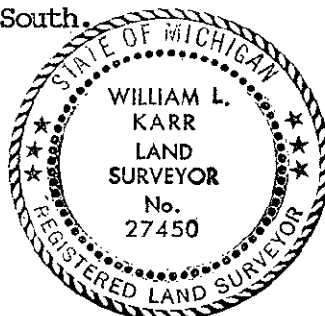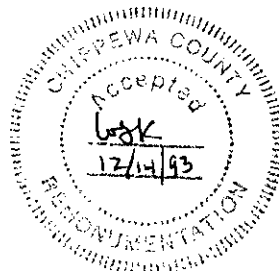

Signed by William L. Karr

Date 12/14/93

Surveyor's Michigan License No. 27450

NOTE: Bearings are compass bearings corrected for declination.
Distances are to a nail in side of witness objects unless noted.