

FEB 18 1994 CLARE COUNTY REMONUMENTATION PROGRAM

COMMISSION

LAND CORNER RECORDATION CERTIFICATE
Filing Requirement of Act 74, Mich. P.A. 1970

RECEIVED
1993 DEC 20 PM 1:44
REGISTER OF DEEDS
CLARE COUNTY
DONNA M. CARR

For corners in

CLARE (County)	Located In:	Corner Code ##
1. Public Land Survey	T 17N R 6W	1-9
	T R	
	T R	
	T R	
2. Property Controlling in Section	S T R	
	S T R	
3. Miscellaneous Property in Sec.	S T R	
	S T R	

Register of Deeds Stamp & File Number

4. Lot No. _____, Recorded Plat _____
5. Private Claims _____

I, MARK R. ROBISON, in a field survey on OCTOBER, 19 93,
do hereby certify that under requirements of P.A. 74, Michigan P.A. of 1970, the corner points mentioned
in lines 1 and 2 above were in conformance with regulations and rules therefore as required in the
current manual of survey instructions of the United States Department of the Interior, Bureau of Land
Management or by a decree of a Court of Law and/or that the corner points mentioned in lines 3, 4 and 5
above were in conformance with the rules of the Michigan Board of Land Surveyors or by a Decree of a
Court of Law; established, re-established, monumented, re-monumented, recovered, found as
expressed below:


NOTE: Not more than 4 corners, all in the same town and range, may be recorded
on this certificate.

- A. Description of original monument and accessories and/or subsequent restoration:
1847 ORSON LYON, POST, PINE 20" N 19-1/2°E, 28 LKS P.319
MAPLE 6" N 77-1/2°W 16 LKS
NO DATE, UNIDENTIFIED, TAMARACK 8" N 60°E, 24 LKS CSR 6-172
5-1-72 LAPHAM, 1-1/2" PIPE, LCRC 24-72
10-2-72 LAPHAM, LCRC 58-72
5-8-74 LAPHAM, (132) 1-723
7-19-74 LAPHAM, LCRC 152-74
9-4-85 MUELLER, (132) 2-895

- B. Description of corner evidence found and/or method applied in restoring or reestablishing corner:
FOUND 1-1/2" x 28" PIPE IN MONUMENT BOX. EXCAVATED TO DEPTH OF 3', DID NOT FIND ANY
OTHER EVIDENCE.
FOUND RECORDED WITNESSES:
N 45°E, 101.3' - 24" MAPLE
S 50°E, 97.35' - ELECT. POLE
N 35°E, 54.38' - TELE. POLE
N 45°W, 98.65' - 4" PINE
N.N.W., 118.58' - 6" STEEL POST
S.E., 49.59' - COR. FENCE POST

This Corner established in Clare County Remonumentation Program.
See dossier for detailed report.

- C. Description of monument for corner and accessories established to perpetuate locating the position of the corner:
SET 5/8" X 36" RE-ROD WITH 3" CLARE COUNTY MONUMENT CAP IN MONUMENT BOX.
S 50°E, 97.60' - POWER POLE
N 50°W, 98.45' - 8" PINE
N.E., 155.4' - 18" OAK
S 45°E, 49.78' - COR. FENCE POST

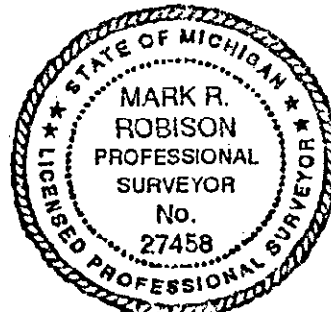

Signed by

Mark R. Robison

Date

11/24/93

Surveyor's Michigan License No.

27458