

# SURVEY & REMONUMENTATION

JAN 17 1996

## LAND CORNER RECORDATION CERTIFICATE COMMISSION Filing Requirement of Act 74, Mich. P.A. 1970

For corners in

CLARE

(County)

Located In:

Corner Code #

1. Public Land Survey

T 17N R 4W A-10

2. Property Controlling  
in Section

S T R

3. Miscellaneous  
Property in Sec.

S T R

4. Lot No. , Recorded Plat

5. Private Claims

I, MARK R. ROBISON, in a field survey on OCTOBER, 19 95 do hereby state that under requirements of P.A. 74, Michigan P.A. of 1970, the corner points mentioned in lines 1 and 2 above were in conformance with regulations and rules therefore as required in the current manual of survey instructions of the United States Department of the Interior, Bureau of Land Management or by a decree of a Court of Law and/or that the corner points mentioned in lines 3, 4 and 5 above were in conformance with the rules of the Michigan Board of Land Surveyors or by a Decree of a Court of Law; established, re-established, monumented, recovered, found as expressed below:

NOTE: Not more than 2 corners, all in the same town and range, may be recorded on this certificate.

A. Description of original monument and accessories and/or subsequent restoration:

1837 JOHN HUDSON  
WIT.-BEECH 19" IS CORNER

NO DATE OR SURVEYOR, CSR  
TYLE, CINDERS & STAKE AT INTERSECTION OF FENCES  
W.P. STUMP 30" S71°E 19

PAUL LAPHAM, (132) SURVEY  
FOUND 1 1/2" PIPE IN TILE  
WIT.-EAST 33.78' 36" ELM  
S20°W 100.45' METER POLE  
WEST 28.51' FENCE POST

6-73 LEONARD URBANIAK, (132) SURVEY  
NO WITNESSES

1-74 PAUL LAPHAM, L.C.R.C.  
FOUND 1 1/2" PIPE IN 3" TILE  
WIT.-EAST 33.78' 36" ELM  
S20°W 100.45' METER POLE  
WEST 28.51' FENCE POST

5-75 PAUL LAPHAM, (132) SURVEY  
SAME AS ABOVE

5-75 PAUL LAPHAM, (132) SURVEY  
SAME AS ABOVE

12-94 MARK ROBISON (132) SURVEY  
FOUND 1 1/2" PIPE IN 3" TILE  
SAME AS ABOVE

B. Description of corner evidence found and/or method applied in restoring or reestablishing corner:

FOUND 1 1/2"x32" PIPE IN 3" CLAY TILE PER C.S.R. NOTES.  
FOUND OLD ELM WITNESS. METER POLE HAS BEEN REPLACED WITH NEW POLE.

APPROVED LAND CORNER

P.A. 345 of 1990

Clare County

Chairman Paul D. Lapham

Date 12-12-95


This Corner established in Clare County Remonumentation Program.

See dossier for detailed report.

C. Description of monument for corner and accessories established to perpetuate locating the position of the corner:

A-10 WEST 1/4 CORNER, SECTION 30  
SET 5/8"x36" RE-ROD WITH 3" CLARE COUNTY MONUMENT  
ACCEPTED AS BEST AVAILABLE EVIDENCE OF THE PERPETUATION OF THE C.S.R. CORNER

WITNESSES:  
EAST 33.78' - NAIL & TAG IN 38" ELM (OBT)  
S20°W 101.50' - NAIL & TAG IN NEW METER POLE  
N75°W 68.94' - NAIL & TAG IN 20" SPRUCE  
S30°E 97.96' - NAIL & TAG IN 14" RED PINE

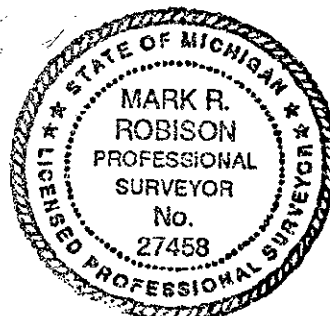

Signed by Mark Robison

Date 12-13-95

Surveyor's Michigan License No. 27458