

SURVEY & REMONUMENTATION

JAN 14 1999

CLARE County Remonumentation

LAND CORNER RECORDATION CERTIFICATE
Filing Requirement of Act 74, Mich. P.A. 1970

SECTION

For corners in

CLARE
(County)

Located in:

Corner Code #

1. Public Land Survey T18N R03W E-5
T R
T R
T R
2. Property Controlling S T R
in Section S T R
3. Miscellaneous S T R
Property in Sec. S T R

4. Lot No. , Recorded Plat
5. Private Claims

I, Mark R Robison, in a field survey on October, 1998 do hereby state that under requirements of P.A. 74, Michigan P.A. of 1970, the corner points mention in lines 1 and 2 above were in conformance with regulations and rules therefore as required in the current manual of survey instructions of the United States Department of the Interior, Bureau of Land Management or by a decree of a Court of Law and/or that the corner points mentioned in lines 3, 4 and 5 above were in conformance with the rules of the Michigan Board of Land Surveyors or by a Decree of a Court of Law; established, re-established, monumented, recovered, found as expressed below:

NOTE: Not more than 2 corners, all in the same town and range, may be recorded on this certificate

A. Description of original monument and accessories and/or subsequent restoration:

E-5: 1856 Cannon, GLO
Old corner 8-9-16-17
No new bearing trees. Meas. East 40.80 to old 1/4 Cor.

1978 Lapham, PBL files
Section Sub. of Sec. 16, Meas. East 2669.52

1903 Johnson, CSR 5-26
No witnesses or distances

1907 Johnson, CSR 4-52, 5-104
W. Pine 30 S75W 56
Tel. Pole S51E 64
Meas. East 40.50 & 40.48

1982 Merry (132) 2-707
Fd. PK Nail
Meas. East 2669.54

B. Description of corner evidence found and/or method applied in restoring or reestablishing corner:


E-5: Found Monument box (no stake) in center of E-W road & 2 feet West of center of N-S road. Measured East 2668.20 feet, (GLO proportional 2669.22 & CSR 2673 & 2671.68). Meas. 980 (GLO 990) West to base of hill and 1150 West (GLO 1174) to stream. Accepted position of corner as center of monument box.

See dossier for detailed information

C. Description of monument for corner and accessories established to perpetuate locating the position of the corner:

E-5: Set 5/8"X36" re-rod with Clare CO, remon cap marked PS 27458 in mon box. Accepted as best available evidence of the accepted position of the corner.

S39E 46.44 Nail & Tag in Cor, Fence Post
N48E 59.04 Nail & Tag in 7" Elm
N45W 47.46 Nail & Tag in Stud P.P.
S54W 48.24 Nail & Tag in Cor. Fence Post

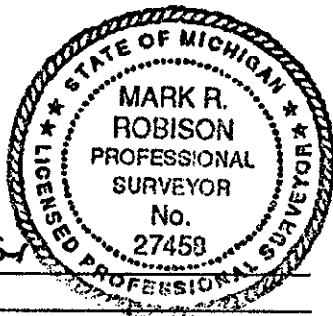

Signed by Mark R. Robison
Surveyor's Michigan License No. 27458

Date 12-23-98

APPROVED LAND CORNER

P.A. 345 of 1990
Clare County

Chairman Paul H. Lapham
Date 12-08-98

RECEIVED
317-98
98 DEC 29 PM 3:04
REGISTER OF DEEDS
CLARE COUNTY
CAROL A. McAULAY

Register of Deeds Stamp & File Number

	A	B	C	D	E	F	G	H	I	J	K	L	M
1													
2	6		5		4		3		2		1		
3													
4	7		8		9		10		11		12		
5													
6	18		17		16		15		14		13		
7													
8	19		20		21		22		23		24		
9													
10	30		29		28		27		26		25		
11													
12	31		32		33		34		35		36		
13													