

NOV 18 1997

CLARE COUNTY REMONUMENTATION

COMMISSION LAND CORNER RECORDATION CERTIFICATE Filing Requirement of Act 74, Mich. P.A. 1970

RECEIVED

# 224-97 97 OCT 15 AM 10:53

REGISTER OF DEEDS CLARE COUNTY CAROL A. McAULAY

GREENWOOD LINCOLN

Register of Deeds Stamp & File Number

corners in	Located In:	Corner Code #
CLARE (County)		
Public Land Survey	T 19N R 5W	K-13
	T 18N R 5W	K-1
	T R	
	T R	
Property Controlling in Section	S T R	
Miscellaneous	S T R	
Property in Sec.	S T R	

Lot No. \_\_\_\_\_, Recorded Plat \_\_\_\_\_ Private Claims \_\_\_\_\_

MARK R. ROBISON, in a field survey on July 1, 1997 do hereby state that under requirements of P.A. 74, Michigan P.A. of 1970, the corner points mentioned in lines 1 and 2 above were in conformance with regulations and rules therefore as required in the current manual of survey instructions of the United States Department of the Interior, Bureau of Land Management or by a decree of a Court of Law and/or at the corner points mentioned in lines 3, 4 and 5 above were in conformance with the rules of the Michigan Board of Land Surveyors or by a Decree of a Court of Law, established, re-established, monumented, re-covered, found as expressed below:

NOTE: Not more than 2 corners, all in the same town and range, may be recorded on this certificate.

A	B	C	D	E	F	G	H	I	J	K	L	M
1												
2	6	5	4	3	2	1						
3												
4	7	8	9	10	11	12						
5												
6	18	17	16	15	14	13						
7												
8	19	20	21	22	23	24						
9												
10	30	29	28	27	26	25						
11												
12	31	32	33	34	35	36						
13												

- 1838 Nicholson Set Post Cor. Sec's 35 & 36 Wit.-W. Pine 50 N77E 20 W. Pine 22 N87W 21
- 1856 Cannon-G.L.O. Resurvey Wit.-W. Oak 12" S39E 43 W. Pine 30" S15W 67
- 6-29-12 Johnson C.S.R. 2-16 & 6-37 Wit.-W. Pine Stmp. 50" N71E 20 W. Pine Stmp. 22" N77W 21 Meas. 39.60 to East
- 04-02-74 Lapham (132) 1-715 Found 1" Pipe Wit.-N30W 83.7 14" Oak East 71.65 Triple 14" Oak S25W 67.9 24" Oak
- 7-19-74 Lapham L.C.R.C.# 153 Wit.-same as (132) 1-715

- 2-27-80 Sedgman (132) 2-574 & 2-575 Found 1" Pipe Wit.-West 28.82 P.P. N35W 84.08 16" Trip. Oak N85E 34.77 18" Oak S70E 54.12 18" Trip. Oak
- 4-28-80 Sedgman (132) 2-579 Reference Corner
- 7-30-80 Sedgman L.C.R.C.# 376 Wit.-same as (132) 2-574

B. Description of corner evidence found and/or method applied in restoring or reestablishing corner: Found all 1974 and 1980 witnesses. Excavated at corner. Found 18" sucker rod, 12" x 5" x 1/2" metal plate, 6" x 1" x 1/4" bar, pieces of old clay tile, and stones around corner.

See dossier for detailed report.


APPROVED LAND CORNER P.A. 345 of 1990 Clare County

Chairman [Signature] Date 9-23-97

C. Description of monument for corner and accessories established to perpetuate locating the position of the corner:

K-13: Corner common to Sections 35 & 36, T19N, R5W, AND Sections 1 & 2, T18N, R5W (K-1). Set 5/8" x 36" rerod with 3" Clare County Monument Cap marked P.S.#27458. Accepted as best available evidence of perpetuation of C.S.R. Corner.

- Witnesses: N30W 83.70', set N&T, 21" Oak (OBT)
- S70E 54.12', set N&T, 20" Tr. Oak (OBT)
- East 71.65', set N&T, 20" Trip. Oak (OBT)
- S25W 67.90', set N&T, 44" Oak (OBT)
- West 28.82', set N&T, P.P. (OBT)

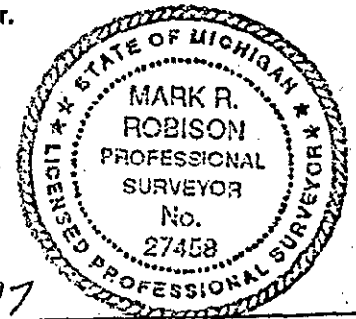

Signed by [Signature] Surveyor's Michigan License No. 27458

Date 10-01-97