

LAND CORNER RECORDATION CERTIFICATE
Filing Requirement of Act 74, Mich. P.A. 1970

For corners in

CLARE

(County)

Located In:

Corner Code ##

1. Public Land Survey T 20M R 5M J-13. K-12.
T R K-13
T R
T R
T R
2. Property Controlling S 35 T R 7
in Section S T R
3. Miscellaneous S T R
Property in Sec. S T R

Register of Deeds Stamp & File Number

4. Lot No. , Recorded Plat
5. Private Claims

I, CARL F. ROSER, in a field survey on MAY 7, 19 91, do hereby certify that under requirements of P.A. 74, Michigan P.A. of 1970, the corner points mentioned in lines 1 and 2 above were in conformance with regulations and rules therefore as required in the current manual of survey instructions of the United States Department of the Interior, Bureau of Land Management or by a decree of a Court of Law and/or that the corner points mentioned in lines 3, 4 and 5 above were in conformance with the rules of the Michigan Board of Land Surveyors or by a Decree of a Court of Law; established, re-established, monumented, re-monumented, recovered, found as expressed below:

NOTE: Not more than 4 corners, all in the same town and range, may be recorded on this certificate.

A. Description of original monument and accessories and/or subsequent restoration:

J-13 K-12 K-13


	A	B	C	D	E	F	G	H	I	J	K	L	M
2		6		5		4		3		2		1	
3													
4		7		8		9		10		11		12	
5													
6		18		17		16		15		14		13	
7													
8		19		20		21		22		23		24	
9													
10		30		29		28		27		26		25	
11													
12		31		32		33		34		35		36	
13													

7

B. Description of corner evidence found and/or method applied in restoring or reestablishing corner:

J-13 K-12 K-13 7

RECOVERED OLD 1 1/4" PIPE FD 1/2" REROD FOR W 1/4 COR OF ESTABLISHED SE COR OF NE 1/4
(DROVE 1/2" REROD INSIDE) FOR SEC 36. COR IS IN CENTER N-S OF NE 1/4 OF SEC 35 PER
S 1/4 COR SEC 35. OLD FN COR BIT ROAD & IN LINE W/OLD FN WITS. CENTER N-S BIT ROAD IS STANDARD BLM INSTRUCTIONS.
(FN REMAINS E-W-S) IS 28' 2' EAST. CENTER GRAVEL ROAD
SOUTH. NEWER COR POST (OLD FN TO E & W IS 4'± NORTH.
REMAINS N & NEW FN POSTS N & W) IS 28' NORTH. CTR E-W
GRAVEL ROAD IS 2'± SOUTH.

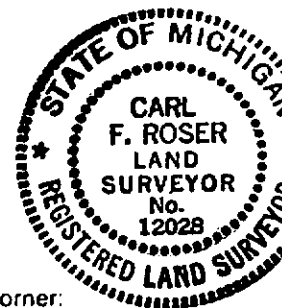

C. Description of monument for corner and accessories established to perpetuate locating the position of the corner:

J-13 K-12 K-13 7

DROVE 1/2" X 32" REROD IN FD FD 1/2" REROD. FD 1/2" REROD (2" DEEP). DROVE 5/8" X 20" REROD W/RLS
OLD 1 1/4" PIPE. 10" R PINE 588°W 43.22' CTR 12" X 12" X 36" CAP.
18" W PINE N75°E 101.62' POWER POLE N30°E 66.69' TALL TELE RISER N40°W 59.4' 11" W OAK N55°W 116.1'
10" R PINE S30°E 40.28' 8" J PINE S75°E 39.76' *POWER POLE N70°E 96.73' 16" B OAK (CLP3) N55°E 84.3'
4" SCTCH PINE S30°W 38.70' *6" BALSAM S45°W 70.00' *7" ELM S40°E 83.05' 23" B OAK S45°E 87.5'
*COR FN POST NORTH 28.46' SET CED POST W/ *9" TW CHERRY S60°W 91.72' SET CED POST W/
*OLD COR FN POST SOUTH 28.36' LOC TAG. EAST 33' LOC TAG. WEST 33'

*FD LS PAUL LAPHAM NAIL & TAG *LS PAUL LAPHAM WIT.

*LS PAUL LAPHAM 1984 WIT.

Signed by Carl F. Roser Date 8-10-92

Surveyor's Michigan License No. 12028