

# SURVEY & REMONUMENTATION

MAR 21 1997

COMMISSION

## REMONUMENTATION SECTIONS 8 & 9, OLIVE TOWNSHIP LAND CORNER RECORDATION CERTIFICATE Filing Requirement of Act 74, Mich. P.A. 1970

RECORDED

For corners in

Clinton  
(County)

Located In:

Corner Code #

1. Public Land Survey

T 6N R 2W E 4  
T     R      
T     R      
T     R      
T     R      
S     T     R      
S     T     R      
S     T     R      
S     T     R    

2. Property Controlling  
In Section

3. Miscellaneous  
Property in Sec.

4. Lot No.       , Recorded Plat         
5. Private Claims       

I, Arden S. Pierson P.S., in a field survey on August 13, 1996, do hereby state that under requirements of P.A. 74, Michigan P.A. of 1970, the corner points mentioned in lines 1 and 2 above were in conformance with regulations and rules therefore as required in the current manual of survey instructions of the United States Department of the Interior, Bureau of Land Management or by a decree of a Court of Law and/or that the corner points mentioned in lines 3, 4 and 5 above were in conformance with the rules of the Michigan Board of Land Surveyors or by a Decree of a Court of Law; established, re-established, monumented, recovered, found as expressed below:

NOTE: Not more than 2 corners, all in the same town and range, may be recorded on this certificate.

Oct 11 8 52 AM '96  
REGISTERED DEEDS  
CLINTON COUNTY, MICH.  
*Carol M. Wray*

LIBER 4, PAGE 165

Register of Deeds Stamp & File Number

	A	B	C	D	E	F	G	H	I	J	K	L	M
1													
2	6			5		4		3		2		1	
3													
4	7			8		9		10		11		12	
5													
6	18			17		16		15		14		13	
7													
8	19			20		21		22		23		24	
9													
10	30			29		28		27		26		25	
11													
12	31			32		33		34		35		36	
13													

A. Description of original monument and accessories and/or subsequent restoration:

- ◆ Original survey by Hervey Parke, DS, 1826. Set 1/4 Section Post, witnessed by: Hickory 9" - N13°W - 05 links; Elm 14" - S14°E - 34 links.
- ◆ LCRC by Clyde Stephens, PS, #3829, dated June 7, 1971, Liber 1, pages 25-26. A 3/4" iron pipe set in the centerline of the section line road (Loomis Road) and on a projection of the old farm fences East and West of the corner. Witnessed by:  
Stephens Engineering tag in triple 8" Box Elder - N32°50'E - 48.95'  
Stephens tag in twin 8" Oak - N61°23'E - 63.20'  
Stephens tag in quadripartite 12" Maple - S51°55'E - 70.30'
- ◆ Certified Survey by Bruce Floyd, PS, #28068, dated September 19, 1986, Liber 2, page 978-979.

B. Description of corner evidence found and/or method applied in restoring or reestablishing corner:

Found "T" iron at East edge road bed - buried 2'. Excavated 5' below road surface and found nothing else. (Used by Porter and Floyd in Certified Surveys.) Accepted "T" iron as a careful and faithful reestablishment of the position of the original corner. (Stephen's corner is West 15.48'.)

\*Set Standard Clinton County Monument and monument box.

C. Description of monument for corner and accessories established to perpetuate locating the position of the corner:

1/4 Corner Common to Sections 8 & 9

- \*Set Standard Clinton County Monument and monument box.
- Nail & tag #13039 in SE side Triple 18" Oak - N60°E - 51.47'
- Nail & tag #13039 in S. Side Power Pole - S86°E - 16.88'
- Nail & tag #13039 in NE side Quad 20" Maple - S35°E - 60.30'
- Nail & tag #13039 in NW side 8" Gate Post - S67°W - 55.98'


(Stephen's Corner is S84°37'27"W - 15.48')

\*Standard Clinton County Monument is a 2 1/2" dia. Steel tube 30" long with a stamped brass cap and a breakaway magnetic base.

Signed by Arden S. Pierson

Date August 15, 1996

Surveyor's Michigan License No. 13039

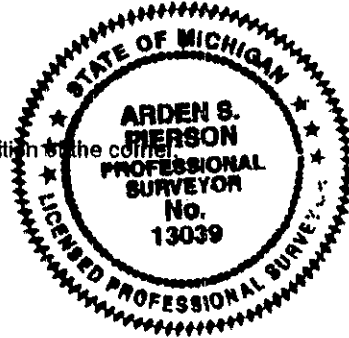

APPROVED BY  
CLINTON COUNTY PEER GROUP  
DATED 8/21/96  
J. J. J.

FORM APPROVED BY MICHIGAN STATE BOARD OF PROFESSIONAL SURVEYORS, JAN. 28, 1971  
REVISED MAY 14, 1975  
REVISED JAN. 1983  
REVISED OCT., 1985