

# LAND CORNER RECORDATION CERTIFICATE

Filing Requirement of Act 74, Mich. PA 1970

For Corners In:

Crawford

(County)

Located In

Corner Code #

1. Public Land Survey T 25N R 3W B-6  
T  
2. Property Controlling in Section S T R  
S T R  
3. Miscellaneous Property in Section S T R  
S T R

4. Lot No: Recorded Plat:

5. Private Claims:

I, Carl T. Kiiskila, in a field survey on May 28, 2003 do hereby state that under requirements of PA 74, Michigan PA of 1970, the corner points mentioned in lines 1 and 2 above were in conformance with regulations and rules therefore as required in the current manual of survey instructions of the United States Department of the Interior, Bureau of Land Management or by a decree of a Court of Law and/or that the corner points mentioned in lines 3, 4 and 5 above were in conformance with the rules of the Michigan Board of Land Surveyors or by a Decree of a Court of Law, established, re-established, monumented, recovered, found as expressed below:

**NOTE: Not more than 2 corners, all in the same town and range, may be recorded on this certificate.**

A. Description of original monument and accessories and/or subsequent restoration:

B-6 Liber 120, Page 167, May 1971, C. Eugene Ostling  
R.L.S. # 12026 found a 4" X 6" concrete post for the center  
of section 18.

Liber 445, Page 250 Frank Arleth P.S. #21266 found  
concrete monument for the center of section 18.

Wit: 6" J. Pine S53°E 39.1'  
7" J. Pine N73°W 28.7'  
½" Bar S89°W 33.0'

B. Description of corner evidence found and/or method applies in restoring or re-establishing corner:

B-6 Found concrete monument fitting C. Eugene Ostling's  
and Frank Arleth's survey in section 18.


C. Description of monument for corner and accessories established to perpetuate locating the position of the corner:

B-6 Found concrete monument

Wit: 5" J. Pine N65°W 28.60'  
5" J. Pine S37°W 27.67'  
6" J. Pine S45°E 38.97'  
5" R. Pine N52°W 59.30'  
Carsonite Post North 1'±

Register of Deeds Stamp & File Number

	A	B	C	D	E	F	G	H	I	J	K	L	M
1													
2	6		5		4		3		2		1		
3													
4	7		8		9		10		11		12		
5													
6	18		17		16		15		14		13		
7													
8	19		20		21		22		23		24		
9													
10	30		29		28		27		26		25		
11													
12	31		32		33		34		35		36		
13													

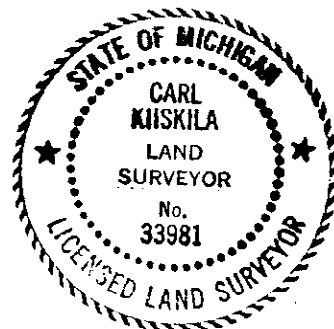

Signed by:

Carl T. Kiiskila

Date:

7-1-03

Surveyor's Michigan License No.:

33981