

# SURVEY & REMONUMENTATION

MAY 05 1997

## LAND CORNER RECORDATION CERTIFICATE

Filing Requirement of Act 74, Mich. P.A. 1970


For corners in **COMMISSION**  
Crawford  
(County)

Located In:

Corner Code #

1. Public Land Survey T 26N R 3W
2. Property Controlling S T R
3. Miscellaneous S T R
- Property in Section S T R

F - 3

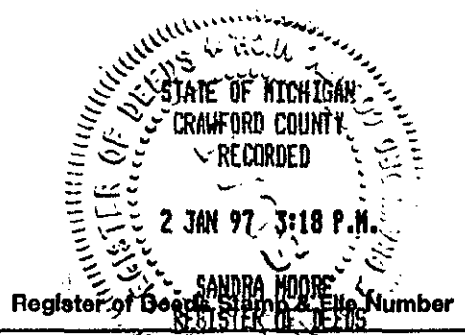

4. Lot No. \_\_\_\_\_, Recorded Plat \_\_\_\_\_
5. Private Claims \_\_\_\_\_

LIBER 3 PAGE 261

I, Marvin E. Myers, in a field survey on December, 19 95, do hereby certify that under requirements of P.A. 74, Michigan P.A. of 1970, the corner points mentioned in lines 1 and 2 above were in conformance with regulations and rules therefore as required in the current manual of survey instructions of the United States Department of the Interior, Bureau of Land Management or by a decree of a Court of Law and/or that the corner points mentioned in lines 3, 4 and 5 above were in conformance with the rules of the Michigan Board of Professional Surveyors or by a Decree of a Court of Law; established, re-established, monumented, re-monumented, recovered, found as expressed below:

**NOTE: Not more than 4 corners, all in the same town and range, may be recorded on this certificate.**

### A. Description of original monument and accessories and/or subsequent restoration:

GLO-James Mullett 1839  
Mon.-Set Post  
WIT: 8" Tamarack N09°W 56 lks.  
5" Tamarack S35°E 31 lks.

M.E. Myers 1991  
Mon.-2" Pipe  
WIT: N-S fence West 2.20'  
Nail W. face 6" Tamarack N33°E 15.43'  
Face of gate post N10°W 2.20'  
Face of gate post S25°W 11.75'  
1½" Pipe S. 33.00'

Eugene Ostling April 1973  
Mon.-Fd. 2" Pipe  
WIT: 8" Spruce N27°W 28.50'  
5" Spruce N50°E 38.70'

Surveyor & Date unknown  
Mon.-Fd. 2" Pipe & Post  
WIT: BT 8" Spruce N27°W 28.50'  
BT 5" Spruce N50°E 38.70'

Gary Boss L.280, pg.37  
Mon.-Unknown  
WIT: None given  
Established along fence as occupied

### B. Description of corner evidence found and/or method applied in restoring or reestablishing corner:

2" x 4" Pipe of record found  
WIT: N-S fence West 2.20'  
Nail W. face 6" Tamarack Stump N40°E 15.95'  
Face of gate post N53°W 2.20'  
Face of gate post S27½°W 11.60'  
1½" Pipe S10°W 32.90'

CRAWFORD COUNTY  
PEER GROUP APPROVAL  
DATE June 17, 1996

Marvin E. Myers  
Marvin E. Myers, P.S.  
County Surveyor

### C. Description of monument for corner and accessories established to perpetuate locating the position of the corner:

Monument - Set standard Crawford County Mon. stamped "MEM 31600" in exact location of fd. pipe  
WIT: Face of gate post S27½°W 11.60'  
Set nail & tag SE side 4" Tamarack N40°E 28.75'  
Set nail & tag SW side 8" Cedar N08°W 73.20'  
Set carsonite post S76°E 0.58'  
Nail N. side 6" Tamarack Stump N40°E 15.95'  
Face wood gate post N53°W 2.20'  
1½" ID Pipe S10°W 32.90'



Signed by

Marvin E. Myers

Date

Surveyor's Michigan License No. 31600

FORM APPROVED BY MICHIGAN STATE BOARD OF PROFESSIONAL SURVEYORS, JAN. 28, 1971  
REVISED MAY 14, 1975  
REVISED JAN., 1983