

LAND CORNER RECORDATION CERTIFICATE
Filing Requirement of Act 74, Mich. P.A. 1970STATE OF MICHIGAN
COUNTY OF CHAWFORD

or corners in

Crawford Located In: Corner Code: #1
(County)

Public Land Survey T 27N R 1W L-13
T R
T R
T R
Property Controlling S T R
in Section S T R
Miscellaneous S T R
Property in Sec. S T R

FILED FOR RECORD THIS

6th DAY OF June, 1990

9:30 am, IN LIBER 2

PAGE 376

Elizabeth H. Wiland

Register of Deeds

Register of Deeds Stamp & File Number

Lot No. _____, Recorded Plat _____
Private Claims _____

Norman C. Caldwell in a field survey on March 19 90

I hereby certify that under requirements of P.A. 74, Michigan P.A. of 1970, the corner points mentioned in lines 1 and 2 above were in conformance with regulations and rules therefore as required in the current manual of survey instructions of the United States Department of the Interior, Bureau of Land Management or by a decree of a Court of Law and/or that the corner points mentioned in lines 3, 4 and 5 above were in conformance with the rules of the Michigan Board of Land Surveyors or by a Decree of a Court of Law; established, re-established, monumented, re-monumented, recovered, found as expressed below:


NOTE: Not more than 4 corners, all in the same town and range, may be recorded on this certificate.

Description of original monument and accessories and/or subsequent restoration:

L-13) Post set by Mullett in 1839.
Aspen 12" N35°W .11 (7.26')
Spruce Pine 6" N28°E .13 (8.58')

Description of corner evidence found and/or method applied in restoring or reestablishing corner:

L-13) LaGuire, 1934, set pipe & conc. block mon. from both orig. BTs.
(down but in excellent condition)
A local cor. with NBTs was East 25.7'

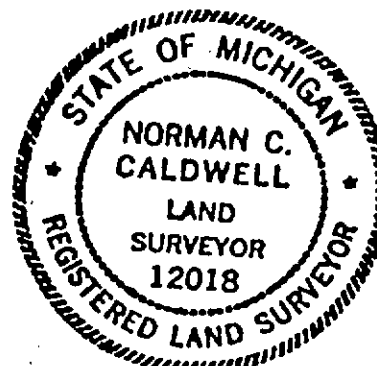

Description of monument for corner and accessories established to perpetuate locating the position of the corner:

L-13) Stand. 1/4 cor. 36, T27N-R1W

Find. 1 3/4" pipe in conc. block by Schaaf as perpetuation of orig. cor. verified by him w/both orig. BTs in excellent condition. And is accepted as a careful & faithful perpetuation of the position of the original corner.

North 1' Carsonite Witness Post N25°E 42.4' 6" Spruce
East 25.4' 1/2" bar w/2x2 hub (no rec.)
S30°E 30.6' 10" J. Pine
S25°W 28.4' 8" Spruce
N40°W 50.4' 6" Spruce

Witnessed by Norman C. Caldwell Date April 26, 1990

Surveyor's Michigan License No. 12018