

SURVEY & REMONUMENTATION

APR 07 1998

SECTION

For corners in

LAND CORNER RECORDATION CERTIFICATE

Filing Requirement of Act 74, Mich. P.A. 1970

Crawford

(County)

Located In:

Corner Code #

1. Public Land Survey

T 26N R 2W

A-1

T 27N R 2W

A-18

T 27N R 3W

M-13

T 26N R 3W

A-13

2. Property Controlling In Section

S

T

R

S

T

R

3. Miscellaneous

S

T

R

Property in Sec.

S

T

R

4. Lot No. , Recorded Plat

5. Private Claims

LIBER

3 PAGE 281

I, Marvin E. Myers, in a field survey on 27 MAY, 1997 do hereby state that under requirements of P.A. 74, Michigan P.A. of 1970, the corner points mentioned in lines 1 and 2 above were in conformance with regulations and rules therefore as required in the current manual of survey instructions of the United States Department of the Interior, Bureau of Land Management or by a decree of a Court of Law and /or that the corner points mentioned in lines 3, 4 and 5 above were in conformance with the rules of the Michigan Board of Land Surveyors or by a Decree of a Court of Law; established, re-established, monumented, recovered, found as expressed below:

NOTE: Not more than 2 corners, all in the same town and range, may be recorded on this certificate.

A. Description of original monument and accessories and/or subsequent restoration:

G.L.O.

15 June 1852

Darwin A. Pettibone D.S.

Mon: Post

Wit: 24" Pine S71°W 1.00 links

18" Yellow Pine N80°E 1.29' links

12" White Pine N18°W 0.94 links

1955 George D. Henning R.L.S.

Unrecorded Survey Sec.6 T26N R2W

Restored from stumps of original U.S. witnesses

Mon: 3/4" square bar in blacktop 9' N. of centerline

Wit: 4" Jack Pine N58°W 58.1

8" Jack Pine N41°E 37.00'

7" Jack Pine S31°W 62.0'

Eugene Ostling R.L.S.#12026

Unrecorded survey, 4 Sept 1971

Mon: 3/4" square Iron

Wit: none provided

Norman F. Parker R.L.S.#16939

Liber 148 Page 07, 26 Sept 1975

Mon: no description provided

Wit: none provided

Robert T. Ostling R.L.S.#5133

Liber 1 Page 59, 14 August 1959

Plat of Ausable Trails

Mon: 3/4" Iron in pavement

Wit: none provided

Norman F. Parker R.L.S.#12026

Unrecorded survey 29 Dec 1986

Mon: no description provided

Wit: none provided

B. Description of corner evidence found and/or method applied in restoring or reestablishing corner:

Found Rail Road spike flush with the asphalt surface 8.5' north of centerline. Verified position by measurement to corners East and West. Accepted position as a perpetuation of the original government Corner, replaced railroad spike in exact location with standard County Monument in pavement monument box.

C. Description of monument for corner and accessories established to perpetuate locating the position of the corner:

Mon - Standard Crawford County monument in Pavement Monument box.

Wit: Spike in Southeast side Utility Pole S53°W 60.60'

Set spike in West side 13" Red Pine S36°W 76.90'

Set spike in East side 8" White Pine S38°E 87.60'

Set spike in 8" Jack Pine N20°W 43.63'


CRAWFORD COUNTY

PEER GROUP APPROVAL

DATE OCT 16, 1997

Marvin E. Myers

Marvin E. Myers, P.S.
County Surveyor

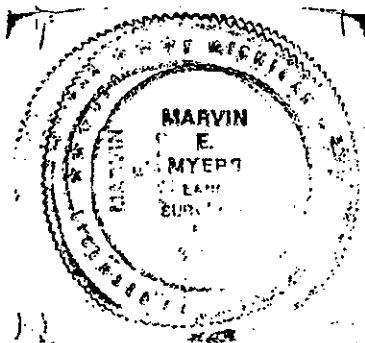

Signed by Marvin E. Myers

Date Dec 15, 1997

Surveyor's Michigan License No. 31600