

# LAND CORNER RECORDATION CERTIFICATE

Filing Requirement of Act 74, Mich. PA 1970

For Corners In:  
Crawford  
 (County)

		Located In		Corner Code #		
1. Public Land Survey	T	_____	R	_____		
	T	_____	R	_____		
2. Property Controlling in Section	S	30	T 27N	R 3W	2	
	S	30	T 27N	R 3w	9	
3. Miscellaneous Property in Section	S	_____	T	_____	R	_____
	S	_____	T	_____	R	_____


Register of Deeds Stamp & File Number

4. Lot No: \_\_\_\_\_ Recorded Plat: \_\_\_\_\_

5. Private Claims: \_\_\_\_\_

I, Carl T. Kiiskila, in a field survey on September 27, 2004 do hereby state that under requirements of PA 74, Michigan PA of 1970, the corner points mentioned in lines 1 and 2 above were in conformance with regulations and rules therefore as required in the current manual of survey instructions of the United States Department of the Interior, Bureau of Land Management or by a decree of a Court of Law and/or that the corner points mentioned in lines 3, 4 and 5 above were in conformance with the rules of the Michigan Board of Land Surveyors or by a Decree of a Court of Law; established, re-established, monumented, recovered, found as expressed below:

**NOTE: Not more than 2 corners, all in the same town and range, may be recorded on this certificate.**

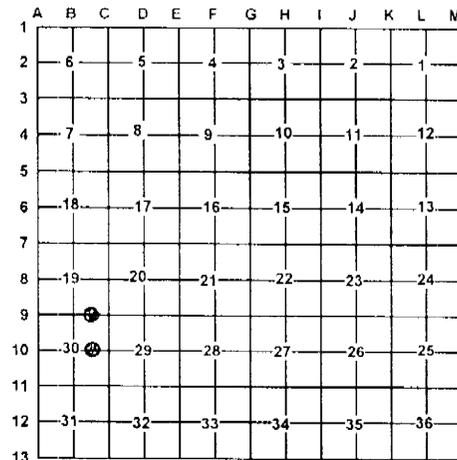

A. Description of original monument and accessories and/or subsequent restoration:

2- This corner position was not established during the original government survey.

9- This corner position was not established during the original government survey.

B. Description of corner evidence found and/or method applies in restoring or re-establishing corner:

2- Established Northwest corner of the Northeast quarter of the Northeast quarter of section 30 as per B.L.M. instructions for the subdivision of a section.

9- Established the Southwest corner of the Southeast quarter of the Northeast quarter of section 30 as per B.L.M. instruction for the subdivision of a section.

C. Description of monument for corner and accessories established to perpetuate locating the position of the corner:

2- Set a 5/8" X 32" capped iron rod with P.S cap #33981  
 Wit: 20" Oak N22°E 18.73'  
 16" Oak S84°E 32.32'  
 18" Oak S43°E 26.04'  
 5" Maple S72°W 13.27'  
 Blue Carsonite Post North 1'±

9- Set a 5/8" X 32" capped iron rod with P.S. cap #33981  
 Wit: 10" Cedar N89°E 11.07'  
 12" Cedar N10°E 10.25'  
 8" Cedar N45°W 25.00'  
 7" Tamarack S27°W 41.05'  
 Blue Carsonite Post North 1'±

Signed by:

Carl T. Kiiskila

Date:

10-6-04

Surveyor's Michigan License No.:

33981

