

LAND CORNER RECORDATION CERTIFICATE

FILING REQUIREMENT OF ACT 74, MICH. P.A.1970

FOR CORNERS OF—	LOCATED IN—	CORNER CODE NUMBER
1. PUBLIC LAND SURVEY_____ T. 27 N. R. 4 W.		M-4; M-5
2. PROPERTY CONTROLLING IN SECTION 12, T. 27 N. R. 4 W.		8; 15
3. MISCELLANEOUS PROPERTY IN SECTION _____, T. _____ S. R. _____ E. W.		
4. LOT NO. _____, RECORDED PLAT _____		
5. PRIVATE CLAIMS _____		

REGISTER OF DEEDS STAMP AND
FILING NUMBER

I, Kenneth J. Olsting, do hereby certify that under requirements of P.A. 74, Michigan P.A. of 1970, the corner points mentioned in lines 1 and 2 above were, in a field survey on September 17, 1975, established, re-established, monumented, re-monumented, recovered or restored as expressed below and in conformance with regulations and rules therefore as required in the current manual of survey instructions of the United States Department of the Interior, Bureau of Land Management or by a decree of a court of law. Furthermore, that the corner points mentioned in lines 3, 4 and 5 above were, in a field survey on _____, 19____, found, recovered, restored, established or re-established as expressed below and in conformance with the rules of the Michigan State Board of Registration for Land Surveyors or, by a Decree of a Court of law:

A. Description of original monument and accessories and/or subsequent restoration:

B. Description of corner evidence found and/or method applied in restoring or re-establishing corner:

- M-4 Set corner by proportionate measurement between section corners; no sign of a previous corner.
- M-5 Found post bottom at corner from USBT stump and other witness of record; very good corner.
- 8 Set by standard survey procedure for the subdivision of sections.
- 15 Set by standard survey procedure for subdivision of sections.


C. Description of monument for corner and accessories established to perpetuate locating the position of the corner:

M-4	M-5	8
Set DNR mon. & red-top post	Set DNR mon. & red-top post	Set 1½"x36" pipe & red-top post
7" Maple S82°E 20.6	18" R. Pine S25°W 12.6	4" W. Pine N48°W 25.3
12" Oak N03°E 33.8	24" Twn.R.Pine S78°E 53.2	3" W. Pine N25°E 23.35
	Gov. witness	
	Pine stump N75°E 21.4	
		15
		3'x1½" pipe & red-top post
		7" W. Birch S43°E 30.4
		3" W. Birch South 37.1

SIGNED BY

Kenneth J. Olsting

DATE

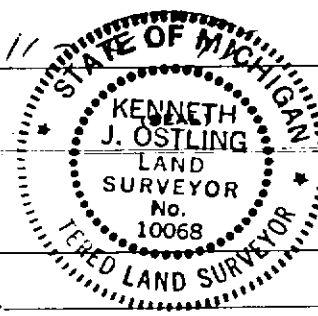

SURVEYOR'S MICHIGAN REGISTRATION NO. 10068

FOR STATE AND UNITED STATES AGENCIES:

SIGNED BY

DATE

CHIEF OF SURVEY PARTY

APPROVED AND SIGNED BY

DATE

MICHIGAN REGISTERED LAND SURVEYOR

(SEAL)

SURVEYOR'S MICHIGAN REGISTRATION NO.