

STATE OF MICHIGAN
DEPARTMENT
OF
NATURAL RESOURCES
LAND CORNER RECORD


CRAWFORD COUNTY
T 28 N R 4 W

DESCRIPTION OF CORNER E 1/16 on S Sec. line

CORNER MONUMENT Set 1"x24" pipe

DATE MONUMENT PLACED AND WITNESSED 5-25-72

WITNESSES TO CORNER.....

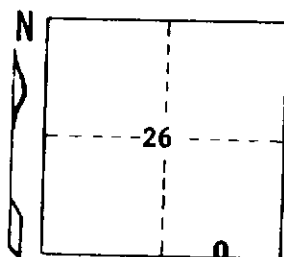

5" Maple S 10 W 17.7'


8" W. Pine N 50 W 46.0'

AND

CIRCLE CORNER REGISTERED

DESCRIPTION IN DETAIL AS TO HOW CORNER WAS LOCATED AND IDENTIFIED OR RESTORED.

Corner set by Standard survey procedure for the subdivision of sections to mark state land boundary.

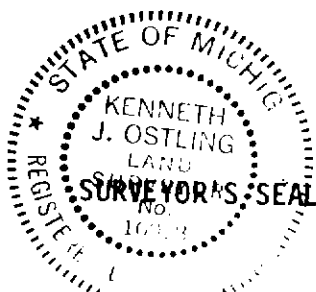

DISTRIBUTION:

Forestry Division, Lansing

SIGNED

Kenneth J. Ostling
REGISTERED LAND SURVEYOR 10068

DATE

5-31-72