


LAND CORNER RECORDATION CERTIFICATE
Filing Requirement of Act 74, Mich. PA 1970

For Corners In: Charlevoix (County)
1. Public Land Survey
2. Property Controlling in Section
3. Miscellaneous Property in Section
4. Lot No: Recorded Plat:
5. Private Claims:

I, Carl T. Kiiskila, in a field survey on November 5, 2009 do hereby state that under requirements of PA 74, Michigan PA of 1970, the corner points mentioned in lines 1 and 2 above were in conformance with regulations and rules therefore as required in the current manual of survey instructions of the United States Department of the Interior, Bureau of Land Management or by a decree of a Court of Law and/or that the corner points mentioned in lines 3, 4 and 5 above were in conformance with the rules of the Michigan Board of Land Surveyors or by a Decree of a Court of Law; established, re-established, monumented, recovered, found as expressed below:
NOTE: Not more than 2 corners, all in the same town and range, may be recorded on this certificate.

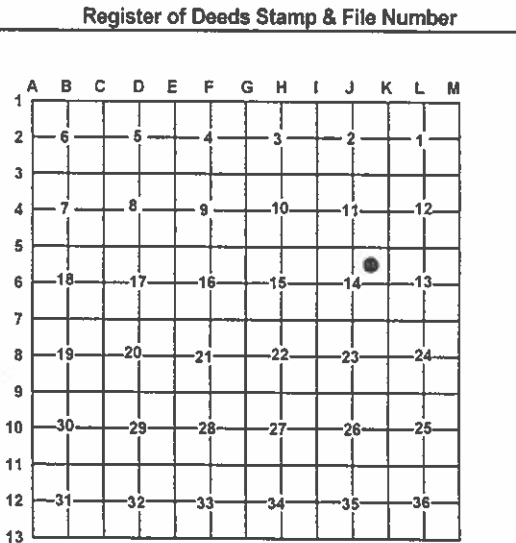

A. Description of original monument and accessories and/or subsequent restoration:
6 - NE 1/16 corner, section 14, T32N, R4W
None

B. Description of corner evidence found and/or method applies in restoring or re-establishing corner:
6 - NE 1/16 corner, section 14, T32N, R4W
Found a Charlevoix Co. monument, consisting of a 3" dia. stamped aluminum cap. Accepted found monument as the best available evidence of the position of the corner. Found no other evidence to dispute the location for the corner.

C. Description of monument for corner and accessories established to perpetuate locating the position of the corner:
6 - NE 1/16 corner, section 14, T32N, R4W
Stamped 3" dia. aluminum cap.
Witnesses:
N04°E 6.13' to set N&T on W side 12" S.Maple
S50°E 7.00' to set N&T on NE side 8" S.Maple
S21°W 17.83' to set N&T on W side 11" S.Maple
S86°W 27.45' to set N&T on S side 4" S.Maple
Set Blue Carsonite Post 1' North



* Previous recorded witness.
Carl T Kiiskila
Surveyor's Michigan License No.: 33981
1-19-10