

SURVEY &  
REMONUMENTATION

APR 06 1995

LAND CORNER RECORDATION CERTIFICATE  
Filing Requirement of Act 74, Mich. P.A. 1970

STATE OF MICHIGAN  
COUNTY OF CHARLEVOIX  
RECEIVED FOR RECORD

1994 DEC 22 PM 2:11

Charlene M. Paschke  
REGISTER OF DEEDS

For corners in  
Charlevoix  
(County)

Located In:

Corner Code #

1. Public Land Survey T 32N R 4W M-8  
T R  
T R  
T R  
2. Property Controlling S T R  
in Section S T R  
3. Miscellaneous S T R  
Property in Sec. S T R

Register of Deeds Stamp & File Number

4. Lot No. , Recorded Plat  
5. Private Claims

I, Arthur R. Ranger, in a field survey on Dec. 14, 1994, do hereby certify that under requirements of P.A. 74, Michigan P.A. of 1970, the corner points mentioned in lines 1 and 2 above were in conformance with regulations and rules therefore as required in the current manual of survey instructions of the United States Department of the Interior, Bureau of Land Management or by a decree of a Court of Law and/or that the corner points mentioned in lines 3, 4 and 5 above were in conformance with the rules of the Michigan Board of Land Surveyors or by a Decree of a Court of Law; established, re-established, monumented, re-monumented, recovered, found as expressed below:

NOTE: Not more than 4 corners, all in the same town and range, may be recorded on this certificate.

	A	B	C	D	E	F	G	H	I	J	K	L	M
2	6		5		4		3		2		1		
3													
4	7		8		9		10		11		12		
5													
6	18		17		16		15		14		13		
7													
8	19		20		21		22		23		24		
9													
10	30		29		28		27		26		25		
11													
12	31		32		33		34		35		36		
13													

A. Description of original monument and accessories and/or subsequent restoration:

- 1840- John Mullet, Surveyor set the Qr. Section Post and witnessed: Beech 8" N64°E 131ks; Sugar 12" S58°W 211ks.  
18-- E.K. Robinson found and witnessed the corner- Sugar 28" S46°W 541ks; Sugar 24" N69.25°W 701ks  
1902 E.A. Robinson, Surveyor found and witnessed the corner- Sugar 6" N50°E 34.51ks; S.E. corner of East wing of farm house N68.75°W 113.331ks


B. Description of corner evidence found and/or method applied in restoring or reestablishing corner:

- 1993/  
1994- Corners position was obliterated. Found evidence of the old farm house Michigan basement hole with old lilac bush on the road side of the former basement hole. Gov't stream tie to the South is in error. The corners position was established by SP measure between M-8 and M-9. The corners position checked reasonably well for and bearing and distance to the eroded basement hole.

C. Description of monument for corner and accessories established to perpetuate locating the position of the corner:

- M-8 Set a 2-3/4" Harrison 20' LONG  
Witnesses:  
6 of 2-track West 11.0'  
8" Maple clump N14°E 30.88'  
7" Maple N42°E 19.09'  
4" Ironwood N78°E 17.09'  
10" Maple S5°E 16.82'

Charlevoix Co. Surveyor  
APPROVED  
Signature May C. Ferrell  
Date: Dec. 15, 1994  
Public Act 345 of 1990

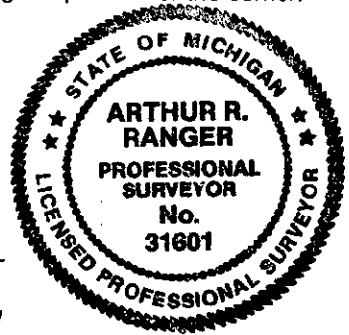

Signed by Arthur R. Ranger

Date Dec. 14, 1994

Surveyor's Michigan License No. 31601