

LAND CORNER RECORDATION CERTIFICATE

Filing Requirement of Act 74, Mich. PA 1970

For Corners In: _____
 Charlevoix _____
 (County) _____

		Located In		Corner Code #
1. Public Land Survey	T	32N	1 5W	I-11
	T	32N	R 5W	I-12
2. Property Controlling in Section	S _____	T _____	R _____	_____
	S _____	T _____	R _____	_____
3. Miscellaneous Property in Section	S _____	T _____	R _____	_____
	S _____	T _____	R _____	_____


4. Lot No: _____ Recorded Plat: _____

5. Private Claims: _____

I, Carl T. Kliskila, in a field survey on June 27, 2005 do hereby state that under requirements of PA 74, Michigan PA of 1970, the corner points mentioned in lines 1 and 2 above were in conformance with regulations and rules therefore as required in the current manual of survey instructions of the United States Department of the Interior, Bureau of Land Management or by a decree of a Court of Law and/or that the corner points mentioned in lines 3, 4 and 5 above were in conformance with the rules of the Michigan Board of Land Surveyors or by a Decree of a Court of Law; established, re-established, monumented, recovered, found as expressed below:

NOTE: Not more than 2 corners, all in the same town and range, may be recorded on this certificate.

Register of Deeds Stamp & File Number

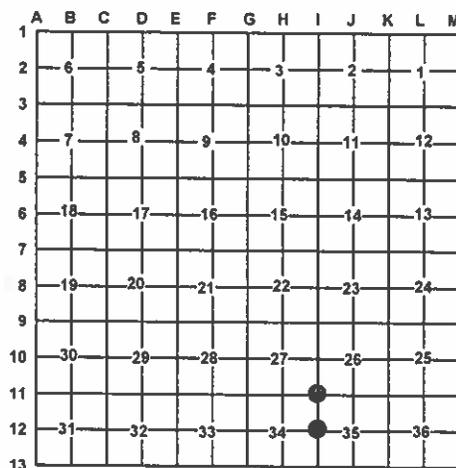

A. Description of original monument and accessories and/or subsequent restoration:

I-11 G.L.O. William Burt 1850 Set Hemlock post corner sections 26,27,34 and 35

Wit: Cedar 10" N20°E 2 links
 Cedar 10" S21°W 25 links

I-12 G.L.O. William Burt 1850 Set Sugar quarter section post

Wit: Hemlock 18" N18°W 33 links
 Y. Birch 5" S32°E 16 links

Michigan State Highway Department tied to the corner while doing a survey in the area in 1947.

September 1904 E.K. Robinson tied to this corner while doing survey work in section 35.

B. Description of corner evidence found and/or method applies in restoring or re-establishing corner:

I-11 Found "T" iron with P.S. cap # 16034 George J. Avendt Jr. fitting Michigan State Highway Department monuments to the East.

I-12 Found boat spike at the intersection of a good fence North, South and East fitting E.K. Robinson distance South.

C. Description of monument for corner and accessories established to perpetuate locating the position of the corner:

I-11 Replaced found "T" iron with a 1" X 32" pipe with standard DNR aluminum cap.

Wit: 13" Twin Birch N48°E 5.91'
 13" Cedar S52°S 6.83'
 6" Spruce S03°W 10.36'
 6" Spruce S36°W 22.50'
 Blue Carsonite Post North 1'±

I-12 Replaced found boat spike with a 1" X 32" pipe with standard DNR aluminum cap.

Wit: Maple N16°W 31.89'
 Maple S82°W 22.34'
 9" Twin Maple S08°W 19.69'
 17" Twin Maple S45°E 13.31'
 Fence going North, South and East
 Blue Carsonite Post North 1'±

Signed by: _____

Carl T Kliskila

Date: _____

8/10/05

Surveyor's Michigan License No.: _____

33981

