

SURVEY & REMONUMENTATION

STATE OF MICHIGAN
COUNTY OF CHARLEVOIX

96 SEP 27 PM 3:25

LAND CORNER RECORDATION CERTIFICATE Filing Requirement of Act 74, Mich. P.A. 1970

OCT 18 1996

For corners in

CHARLEVOIX

(County)

COMMISSION

Located in

Corner Code #

Public Land Survey

T32N R5W

E13

T R

T R

Property Controlling
In Section

S

T R

S

T R

Miscellaneous

S

T R

Property in Sec.

S

T R

Lot No. , Recorded Plat

Private Claims

REGISTER OF DEEDS

Register of Deeds Stamp & File Number

ARTHUR R. RANGER, in a field survey on 05/04, 1996, do hereby state that under requirements of P.A. 74, Michigan P.A. of 1970, the corner points mentioned in lines 1 and 2 above were in conformance with regulations and rules therefore as required in the current manual of survey instructions of the United States Department of the Interior, Bureau of Land Management or by a decree of a Court of Law and for that the corner points mentioned in lines 3, 4 and 5 above were in conformance with the rules of the Michigan Board of Land Surveyors or by a Decree of a Court of Law; established, re-established, monumented, recovered, found as expressed below:

NOTE: Not more than 2 corners, all in the same town and range, may be recorded on this certificate.

	A	B	C	D	E	F	G	H	I	J	K	L	M
1													
2	6		5		4		3		2		1		
3													
4	7		8		9		10		11		12		
5													
6	10		17		16		15		14		13		
7													
8	19		20		21		22		23		24		
9													
10	30		29		28		27		26		25		
11													
12	31		32		33		34		35		36		
13													

a. Description of original monument and accessories and/or subsequent restoration:

E-13

1840- John Mullet set the corner and witnessed:
Hemlock 20" N27 E 8 lks.
Beech 8" N38 W 13 lks.

1971- Carl Roser, surveyor reestablished by SP, per standard BLM instructions.
He set a DNR monument and witnessed: 9" Y. Birch N89 E 17.2'; 9" Maple N10 E 11.2';
7" Ironwood S37 W 30.6'; See LCRC liber 1, pg. 64.

b. Description of corner evidence found and/or method applied in restoring or reestablishing corner:

E-13


1996- Arthur R. Ranger, surveyor found the DNR monument under a deadfall.
The bearing and distances East and West on the Township line seemed reasonable.

c. Description of monument for corner and accessories established to perpetuate locating the position of the corner:

E-13 Found the DNR monument-under a deadfall
7" Ironwood S34 W 31.08'
10" Maple N66 W 12.75'
9" Maple N16 E 11.41'
10" Maple N49 E 23.55'

Charlevoix Co. Surveyor
APPROVED

Signature May C. Feinelt
Date: July 25, 1996

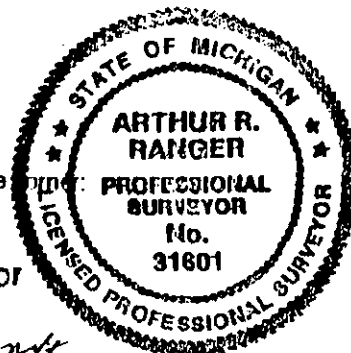

The DNR monument found was accepted as a careful and faithful reestablishment of the position of the original corner.

Signed by Arthur R. Ranger
Surveyor's Michigan License No. 31601

Date 05/24/96

LIBER 003 PAGE 30