

MICHIGAN
DEPARTMENT OF CONSERVATION
FORESTRY DIVISION

LAND CORNER RECORD

T. 33 N.R. 4 W


Charlevoix COUNTY

DESCRIPTION OF CORNER Section corner common to Sections 7-8-17-18

CORNER MONUMENT Set 1" pipe with 4" Aluminum cap

DATE MONUMENT PLACED AND WITNESSED 10/12/61

WITNESSES TO CORNER.....

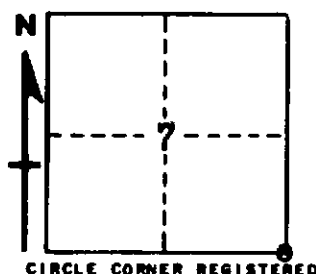

12" Elm - N44W - 49.6 feet

16" Elm - S37E - 24.0 feet

AND

DESCRIPTION IN DETAIL AS TO HOW CORNER WAS LOCATED AND IDENTIFIED OR RESTORED.

This corner was found while making a survey in this area. Found a 1" pipe and old post bottom surrounded by rocks at corner, in line with centerline of county road north and east and fence south. Appears to be in position established in 1905 survey by county surveyor since it checks measurements of record very closely. Found no evidence in support of any other position, so considered this point acceptable as the proper location for corner.

SURVEYOR'S SEAL

SIGNED Kenneth J. Osting DATE 10/17/61
REGISTERED LAND SURVEYOR