

MICHIGAN
DEPARTMENT OF CONSERVATION
FORESTRY DIVISION

LAND CORNER RECORD

T. 33 N.R. 4 W


Charlevoix COUNTY

DESCRIPTION OF CORNER Section corner common to Sections 4-5-8-9

CORNER MONUMENT 1" pipe with 4" A luminum cap

DATE MONUMENT PLACED AND WITNESSED August 17, 1961

WITNESSES TO CORNER.....

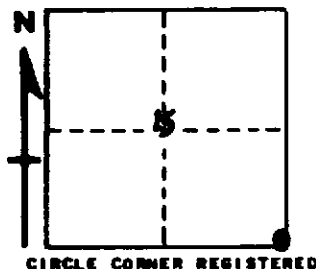

5" Basswood	-	N1 $\frac{1}{2}$ W	-	25.7 feet
8" W. A sh	-	S48W	-	28.9 feet
AND 5" H. Maple	-	S53E	-	18.8 feet

DESCRIPTION IN DETAIL AS TO HOW CORNER WAS LOCATED AND IDENTIFIED OR RESTORED.

This corner was found while making a survey in this area. Found very old remains of post surrounded by rocks at corner, established by County surveyor in 1909 survey, as per records in county courthouse. Two 1909 NBTs in place. Cannot identify USBTs, but consider this point best available evidence of proper location.

SURVEYOR'S SEAL

SIGNED Kenneth J. Ostling DATE 8/18/61
REGISTERED LAND SURVEYOR