

✓

MICHIGAN
DEPARTMENT OF CONSERVATION
FORESTRY DIVISION

LAND CORNER RECORD

T. 33 N.R. 7 W
T. 33 N.R. 8 W


Charlevoix COUNTY

DESCRIPTION OF CORNER Meander Corner common to Sections 24 and 19

CORNER MONUMENT Set 2" x 40" pipe filled with conc. & brass cap 12" above grd.

DATE MONUMENT PLACED AND WITNESSED 12/4/67

WITNESSES TO CORNER.....

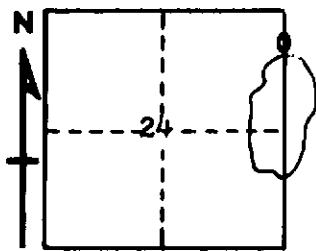

CIRCLE CORNER REGISTERED

7" Cedar	N 48°00' W	12.25'
7" Cedar	N 10°00' E	30.65'
7" Cedar	N 76°00' E	45.85'

AND

DESCRIPTION IN DETAIL AS TO HOW CORNER WAS LOCATED AND IDENTIFIED OR RESTORED.

Set on line and 34.00' from shore.

SURVEYOR'S SEAL

Gregory A. Shadko

SIGNED GRZGORY A. SHADKO DATE 12/12/67
REGISTERED LAND SURVEYOR 10060
~~XXXXXX~~

1934