

MICHIGAN
DEPARTMENT OF CONSERVATION
FORESTRY DIVISION

LAND CORNER RECORD

T. 33 N. R. 1 W


Cheboygan COUNTY

DESCRIPTION OF CORNER 1/4 corner common to sections 22 - 23

CORNER MONUMENT Drove 2" pipe

DATE MONUMENT PLACED AND WITNESSED Sept. 1966

WITNESSES TO CORNER.....

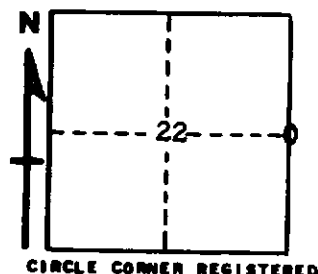

4" H. Maple N 29 E 24.1'

5" Beech N 88 W 58.1'

AND

DESCRIPTION IN DETAIL AS TO HOW CORNER WAS LOCATED AND IDENTIFIED OR RESTORED.

This corner was set by proportionate measurement between section corners while making a survey in this township. Nothing left for USBTs or a previous corner.

SURVEYOR'S SEAL

SIGNED Kenneth J. Ostling DATE 11-18-66
REGISTERED LAND SURVEYOR
#10068