

SURVEY & REMONUMENTATION

SURVEY & REMONUMENTATION

COMMISSION
MAY 05 1997

RE MONUMENTATION LAND CORNER RECORDATION CERTIFICATE Filing Requirement of Act 74, Mich. P.A. 1970

For corners in

Cheboygan

(County)

Located in:

Corner Code #

1. Public Land Survey

T	33N	R	3W	M-2
T		R		
T		R		
T		R		
T		R		
S		R		
S		R		
S		R		
S		R		

2. Property Controlling in Section

3. Miscellaneous Property in Sec.

4. Lot No. _____, Recorded Plat _____

5. Private Claims _____

RECEIVED
FBI RECORDS

96 NOV 25 PM 12:46

Joanna Gray
CLERK/REGISTER
CHEBOYGAN COUNTY, MICHIGAN

Register of Deeds Stamp & File Number

I, Brian K. Fullford, in a field survey on August, 19 96 do hereby state that under requirements of P.A. 74, Michigan P.A. of 1970, the corner points mentioned in lines 1 and 2 above were in conformance with regulations and rules therefore as required in the current manual of survey instructions of the United States Department of the Interior, Bureau of Land Management or by a decree of a Court of Law and/or that the corner points mentioned in lines 3, 4 and 5 above were in conformance with the rules of the Michigan Board of Land Surveyors or by a Decree of a Court of Law; established, re-established, monumented, recovered, found as expressed below.

NOTE: Not more than 2 corners, all in the same town and range, may be recorded on this certificate.

A. Description of original monument and accessories and/or subsequent restoration:

G.L.O.

Set 1/4 Section Post

13" Hemlock N79°E 40 Links

30" Hemlock S83°W 15 Links

1976 Unrecorded Survey

By George Henning #2240

Fnd 1" Pipe by MSHD

14" Elm S54°E 39.23'

18" Elm S25°E 43.25'

18" Elm S10°E 52.25'

B. Description of corner evidence found and/or method applied in restoring or reestablishing corner:

Fnd 1" Pipe by MSHD (BENT)

18" Elm S25°E 43.25' (Fnd Stump)

18" Elm S10°E 52.25' (Fnd Stump)

LIBER 010 PAGE 190

C. Description of monument for corner and accessories established to perpetuate locating the position of the corner:

M-2 Fnd 1" Pipe by MSHD. Replaced 1" Pipe with 5/8" x 36" Bar with Remonumentation Cap. Accepted as a careful faithful re-establishment of the position of the original corner.

4" Basswood N62°E 30.84'

7" Basswood S64°E 16.56'


6" Cedar S66°W 9.43'

4" Cedar N73°W 16.82'



Marvin A. Rus

NOV 25 1996

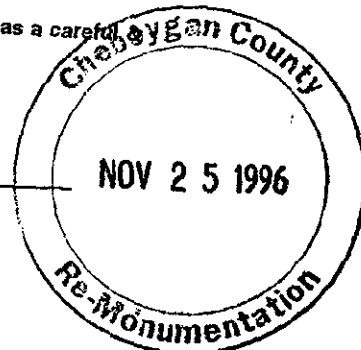

THIS CORNER IS ALSO DESIGNATED AS CORNER CODE #A-2, IN T33N-R2W.

Signed by B. K. Fullford

Surveyor's Michigan License No. 41099

Brian K. Fullford, PS

Date 10/22/96